

# SKETCH OF BOUNDARY SURVEY

SCALE: 1" = 20'



## ABBREVIATION (IF ANY APPLIED)

A = CURVE  
A/C = AIR CONDITIONING UNIT  
ADH = ASPHALT  
B.M. = BENCH MARK  
BLK/CRN = BLOCK CORNER  
CALC(C) = CALCULATED  
CB = CATCH BASIN  
C.B.S. = CONCRETE BLOCK STRUCTURE  
CL = CLEAR  
CONC = CONCRETE  
D.M.E. = DRAINAGE MAINT. EASEMENT  
D = DIAMETER  
EASMT = EASEMENT  
ELEV = ELEVATION  
F.O.H. = FOUND GRILL HOLE  
F.H. = FIRE HYDRANT  
F.N.D. = FOUND NAIL AND DISC  
F.I.P. = FOUND IRON PIPE  
F.S. = FOUND SPIKE  
L.P. = LIGHT POLE  
MEAS(W) = MEASURED  
MH = MANHOLE  
M = MONUMENT  
L = MONUMENT LINE  
NTS = NOT TO SCALE


P/W = PARKWAY  
P.C.B. = POINT OF BEGINNING  
P.O.C. = POINT OF COMMENCEMENT  
P.O.I. = POINT OF INTERSECTION  
P = PROPERTY LINE  
P.P. = POWER POLE  
P.R.M. = PERMANENT REFERENCE MONUMENT  
P.T. = POINT OF TANGENCY  
RAD. = RADIAL  
REC. (R) = RECORDED  
RES. = RESIDENCE  
R/W = RIGHT OF WAY  
SEC. = SECTION  
S.D.N. = SET DRILL HOLE  
S.N.D. = SET NAIL AND DISC  
S.I.P. = SET IRON PIPE  
S.R.B. = SET REBAR  
STY = STOP  
SWK. = SIDEWALK  
T.O.P. = TOP OF BANK  
U.E. = UTIL. EASEMENT  
W.P. = WOODEN POLE  
S = SECTION LINE

## SURVEYOR'S LEGEND (IF ANY APPLIED)

BOUNDARY LINE  
STRUCTURE (BLDG.)  
CONCRETE BLOCK WALL  
METAL FENCE  
WOODEN FENCE  
CHAIN LINK FENCE  
WOOD DECK/DOCK  
ASPHALTED AREAS  
CONCRETE  
BRICKS OR PAVERS  
ROOFED AREAS  
WATER (EDGE OF WATER)

CATCH BASIN  
MANHOLE  
OVERHEAD ELECT.  
POWER POLE  
LIGHT POLE  
HANDICAP SPACE  
FIRE HYDRANT  
EASEMENT LINE  
WATER VALVE  
TV-CABLE BOX  
WATER METER  
CONC. LIGHT POLE

## LOCATION MAP

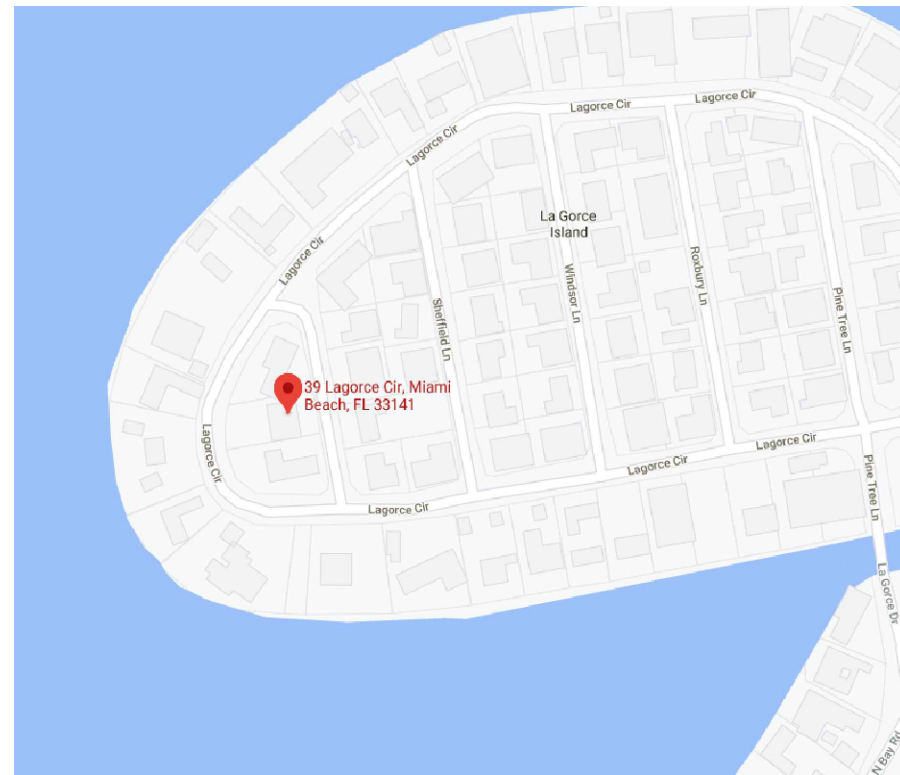

## SITE PICTURE



## LEGAL DESCRIPTION:

LOT 1, BLOCK 11, LA GORCE ISLAND, PLAT BOOK 34 AT PAGE 83, PUBLIC RECORDS, MIAMI-DADE COUNTY, FLORIDA.

LOT 2, BLOCK 11, LA GORCE ISLAND, ACCORDING TO THE MAP OR PLAT THEREOF AS RECORDED IN PLAT BOOK 34 AT PAGE 83, OF THE PUBLIC RECORDS OF MIAMI-DADE COUNTY, FLORIDA.

## JOB SPECIFIC SURVEYOR NOTES:

- THE PROPERTY DESCRIBED ON THIS SURVEY DOES LIE WITHIN A SPECIAL HAZARD AREA AS DEFINED BY THE FEDERAL EMERGENCY MANAGEMENT AGENCY; THE PROPERTY LIES WITHIN A FLOOD ZONE "AE" OF THE FLOOD INSURANCE RATE MAP IDENTIFIED AS COMMUNITY PANEL NO. **120651-0307L**, WITH AN EFFECTIVE DATE OF SEPTEMBER 11, 2009. **BASE FLOOD ELEVATION OF 8.00 FEET** (NGVD)
- LAND AREA OF SUBJECT PROPERTY: **43,936 SF / 1.01 ACRES** (+/-)
- ELEVATIONS ARE BASED ON THE NATIONAL GEODETIC VERTICAL DATUM (NGVD) OF 1929, AS PER MIAMI DADE COUNTY **BENCH MARK No. A-33**, WITH AN ELEVATION OF **8.23 FEET**.
- BEARINGS SHOWN HEREON ARE BASED ON AN ASSUME MERIDIAN OF N.10°20'30"W., BEING THE RECORDED BEARING FOR THE CENTERLINE OF BREVITY LANE., AS SHOWN ON PLAT BOOK 34 AT PAGE 83 OF THE PUBLIC RECORD OF MIAMI DADE COUNTY, FLORIDA.

## GENERAL SURVEYOR NOTES:

THE SHOWN LEGAL DESCRIPTION USED TO PERFORM THIS BOUNDARY SURVEY WAS PROVIDED BY THE CLIENT.

SURVEY IS BASED ON RECORDED INFORMATION PROVIDED BY CLIENT. NO SPECIFIC SEARCH OF THE PUBLIC RECORD HAS BEEN MADE BY OUR OFFICE.

UNLESS OTHERWISE NOTED, AN EXAMINATION OF THE ABSTRACT OF TITLE WAS NOT DONE BY THE SIGNING SURVEYOR TO DETERMINE WHICH INSTRUMENTS, IF ANY ARE AFFECTING THE SUBJECT PROPERTY.

THIS SURVEY IS EXCLUSIVELY FOR THE USE OF THE PARTIES TO WHOM IT WAS CERTIFIED.

PURSUANT TO RULE 53-17 OF THE FLORIDA ADMINISTRATIVE CODE THE EXPECTED USE OF LAND IS SUBURBAN. THE MINIMUM RELATIVE DISTANCE ACCURACY FOR THIS TYPE OF SURVEY IS 1 FOOT IN 7,500 FEET. THE ACCURACY OBTAINED BY MEASUREMENT AND CALCULATIONS OF CLOSED GEOMETRIC FIGURES WAS FOUND TO EXCEED THIS REQUIREMENT.

THERE ARE NO VISIBLE, ABOVE GROUND ENCROACHMENTS (a) BY THE IMPROVEMENTS OF THE SUBJECT PROPERTY UPON ADJOINING PROPERTIES, STREETS OR ALLEYS, OR (b) BY THE IMPROVEMENTS OF THE ADJOINING PROPERTIES, STREETS OR ALLEYS UPON THE SUBJECT PROPERTY OTHER THAN THOSE SHOWN ON THIS BOUNDARY SURVEY.

THERE ARE NO VISIBLE EASEMENTS OR RIGHT-OF-WAY OF WHICH THE UNDERSIGNED HAS BEEN ADVISED OTHER THAN THOSE SHOWN ON THIS SURVEY.

THE MAP OF SURVEY IS INTENDED TO BE DISPLAYED AT THE SHOWN GRAPHIC SCALE IN ENGLISH UNITS OF MEASUREMENT. IN SOME CASES GRAPHIC REPRESENTATION HAVE BEEN EXAGGERATED TO MORE CLEARLY ILLUSTRATE A PARTICULAR AREA WHERE DIMENSIONS SHALL HAVE PREFERENCE OVER GRAPHIC LOCATION.

THE ELEVATIONS (IF ANY) OF WELL-IDENTIFIED FEATURES AS DEPICTED ON THIS SURVEY AND MAP WERE MEASURED TO AN ESTIMATED VERTICAL POSITIONAL ACCURACY OF  $\frac{1}{10}$  FOOT FOR NATURAL GROUND SURFACES AND  $\frac{1}{100}$  FOOT FOR HARDSCAPE SURFACES, INCLUDING PAVEMENT, CURBS, SIDEWALKS AND OTHER MANMADE STRUCTURES.


THE SURVEYOR MAKES NO REPRESENTATION AS TO OWNERSHIP, POSSESSION OR OCCUPATION OF THE SUBJECT PROPERTY BY ANY ENTITY OR INDIVIDUAL.

ANY FEMA FLOOD ZONE INFORMATION PROVIDED ON THIS SURVEY IS FOR INFORMATIONAL PURPOSE ONLY AND IT WAS OBTAINED AT WWW.FEMA.COM.

IF YOU ARE READING THIS BOUNDARY SURVEY IN AN ELECTRONIC FORMAT, THE INFORMATION CONTAINED ON THIS DOCUMENT IS ONLY VALID IF THIS DOCUMENT IS ELECTRONICALLY SIGNED AS SPECIFIED IN CHAPTER 53-17.062 (3) OF THE FLORIDA ADMINISTRATIVE CODE. IF THIS DOCUMENT IS IN PAPER FORMAT, IT IS NOT VALID WITHOUT THE SIGNATURE AND ORIGINAL RAISED SEAL OF THE PROFESSIONAL LAND SURVEYOR AND MAPPER OF RECORD.

WE HEREBY CERTIFY THAT THIS BOUNDARY AND TOPOGRAPHICAL SURVEY AND THE SURVEY MAP RESULTING THEREFROM WAS PERFORMED UNDER MY SUPERVISION AND/OR DIRECTION AND IS TRUE AND CORRECT TO THE BEST OF MY KNOWLEDGE AND BELIEF AND FURTHER, THAT SAID "BOUNDARY AND TOPOGRAPHICAL SURVEY" MEETS THE INTENT OF THE APPLICABLE PROVISIONS OF THE "STANDARDS OF PRACTICE FOR LAND SURVEYING IN THE STATE OF FLORIDA", PURSUANT TO RULE 53-17 OF THE FLORIDA ADMINISTRATIVE CODE AND ITS IMPLEMENTING LAW, CHAPTER 472.027 FOR THE FLORIDA STATUTES.

This item has been digitally signed and sealed by Ed Pino, PSM, on the date adjacent to the seal. Printed copies of this document are not considered signed and sealed and the signature must be verified on any electronic copies.

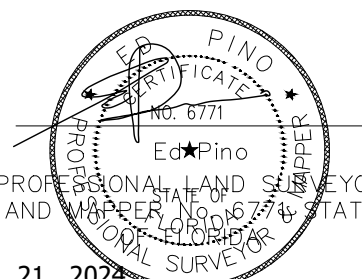

DATE : OCTOBER 21, 2024

CERTIFIED TO:  
BART REINES LUXURY HOMEBUILDER

SITE ADDRESS: 41 LA GORCE CIR, MIAMI BEACH, FL, 33141  
JOB NUMBER: 21-163  
DATE OF SURVEY: FEBRUARY 12, 2021/ FEBRUARY 15, ARBORIST REPORT/ JUNE 24, 2022 (UPDATE)/ OCTOBER 9, 2024 (SPOT)  
FOLIO NUMBER: 02-3210-003-0300

## ENCROACHMENTS AND OTHER POINTS OF INTEREST:

- THERE ARE NO VISIBLE ENCROACHMENT OF THE SUBJECT PROPERTY
- THE SUBJECT PROPERTY IS WITHIN A FLOOD ZONE AE (SEE NOTE 1)
- THERE IS ANY UTIL. EASEMENT ON THE SIDES OF THE SUBJECT PROPERTY

AMERICAN SERVICES OF MIAMI, CORP.  
Consulting Engineers . Planners . Surveyors

266 GIRALDA AVENUE  
CORAL GABLES, FL 33134  
PHONE: (305) 598-8627  
ASONSURV.COM

FOR CLIENT  
SCALE: 1"=20'  
DATE: 10/18/24  
DESIGNED BY: E.P.  
APPROVED BY: E.P.  
DRAWN BY: D.A.  
FIELD BOOK No.  
CHECKED BY: E.P.  
PAGE No. 1

ORDER No.  
21-163

SHEET No.  
1