
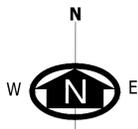


SKETCH OF BOUNDARY SURVEY

SCALE: 1" = 20'


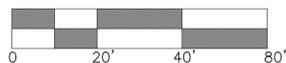


ABBREVIATION (IF ANY APPLIED)

ARC = CURVE
A/C = AIR CONDITIONING UNIT
ASPH = ASPHALT
B.M. = BENCH MARK
Blk./Cor. = BLOCK CORNER
CB = CATCH BASIN
C.B.S. = CONCRETE BLOCK STRUCTURE
CL = CLEAR
CONC. = CONCRETE
Ø = DIAMETER
EASMT. = EASEMENT
ELEV. = ELEVATION
ENC. = ENCROACHMENT
F.D./H. = FOUND DRILL HOLE
F.H. = FIRE HYDRANT
F.N./D. = FOUND NAIL AND DISC
F.I.P. = FOUND IRON PIPE
F.S. = FOUND SPIKE
L.P. = LIGHT POLE
MEAS(M) = MEASURED
MH = MANHOLE

SURVEYOR'S LEGEND (IF ANY APPLIED)

BOUNDARY LINE
STRUCTURE (BLDG.)
CONCRETE BLOCK WALL
METAL FENCE
WOODEN FENCE
CHAIN LINK FENCE
OVERHEAD ELECT.
EASEMENT LINE
WOOD DECK/DOCK
ASPHALTED AREAS
CONCRETE
BRICKS OR PAVERS
ROOFED AREAS
WATER (EDGE OF WATER)
PALM
CATCH BASIN
MANHOLE
CONC. LIGHT POLE
WOOD POWER POLE
METAL LIGHT POLE
FIRE HYDRANT
WATER VALVE
ELECTRIC BOX
CLEAN OUT
HANDICAP SPACE
PEDESTRIAN TRAFFIC LIGHT
TRAFFIC SIGNAL
TREE

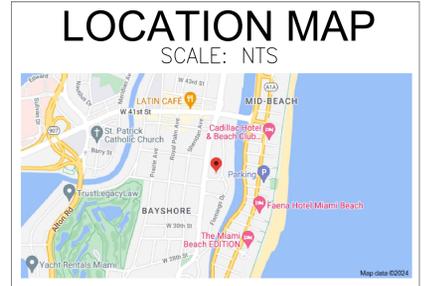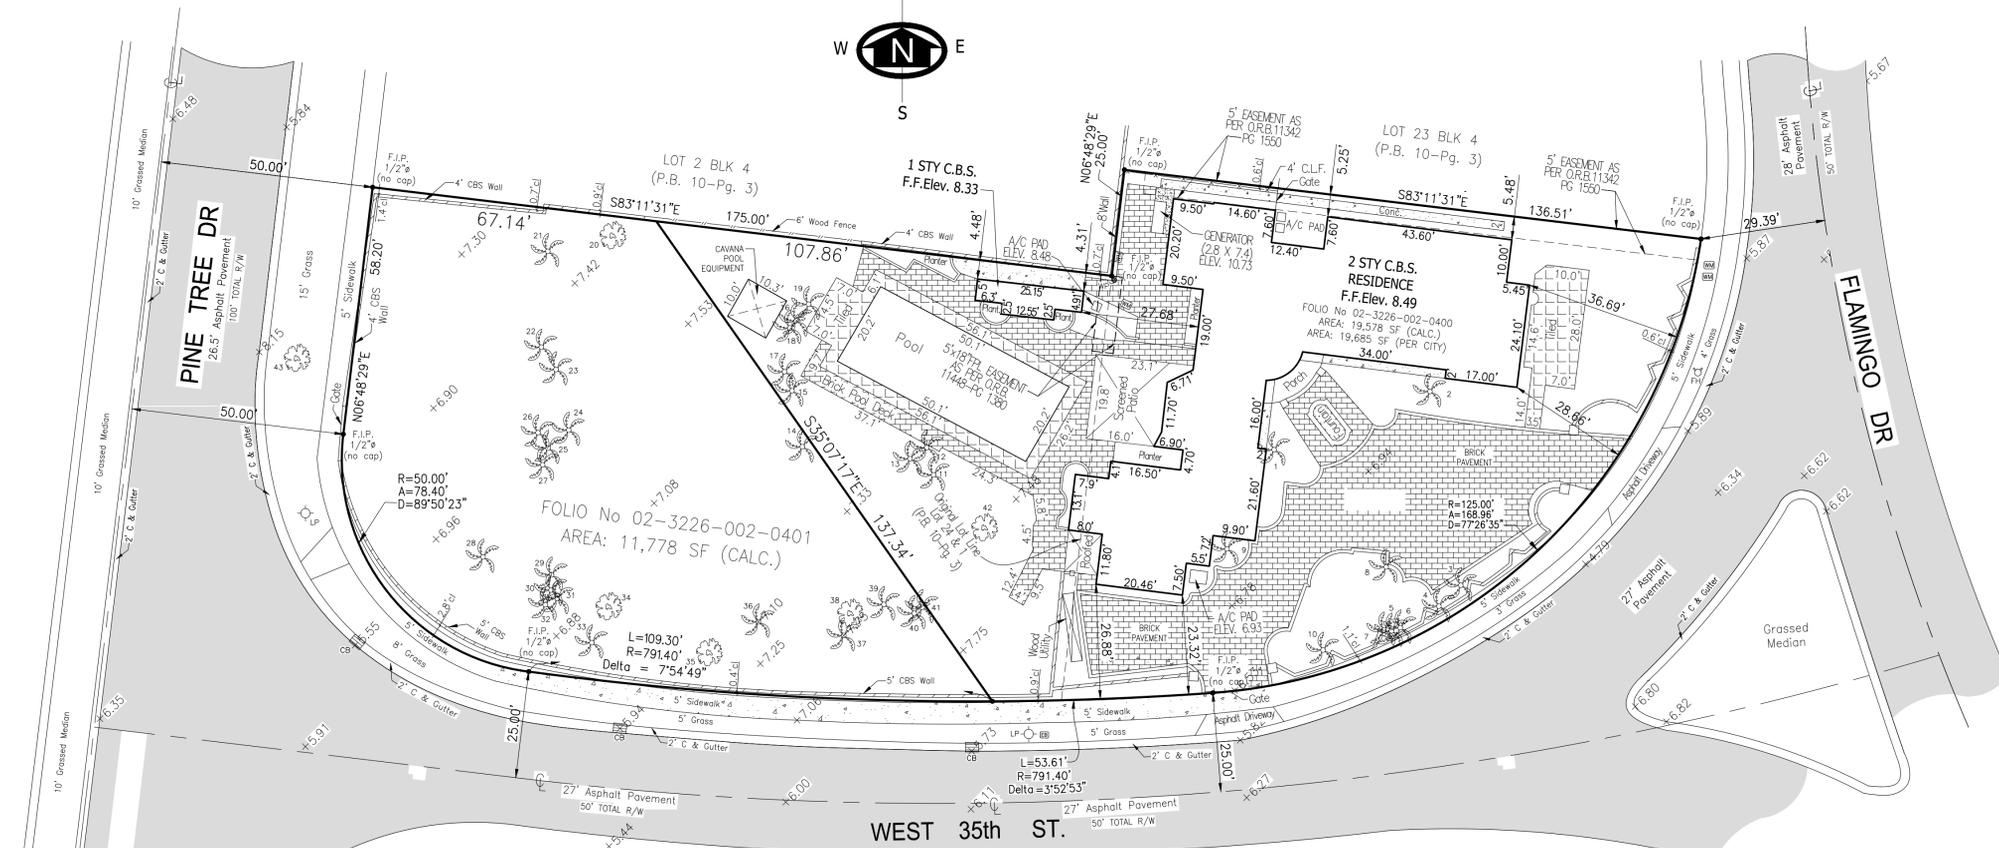

LEGAL DESCRIPTION:
LOTS 1 AND 24, BLOCK 4, FLAMINGO TERRACE SUBDIVISION, ACCORDING TO THE PLAT THEREOF, AS RECORDED IN PLAT BOOK 10, PAGE 4, OF THE PUBLIC RECORDS OF MIAMI-DADE COUNTY, FLORIDA.

SITE ADDRESS: 3500 FLAMINGO DR, MIAMI, FL 33140
JOB NUMBER: 24-430
DATE OF SURVEY: FEBRUARY 7, 2025
FOLIO NUMBER: 02-3226-002-0400 AND 02-3226-002-0401

JOB SPECIFIC SURVEYOR NOTES:

- THE PROPERTY DESCRIBED ON THIS SURVEY DOES LIE WITHIN A SPECIAL HAZARD AREA AS DEFINED BY THE FEDERAL EMERGENCY MANAGEMENT AGENCY; THE PROPERTY LIES WITHIN A FLOOD ZONE "AE" OF THE FLOOD INSURANCE RATE MAP IDENTIFIED AS COMMUNITY PANEL No. 12086C-0317L, WITH AN EFFECTIVE DATE OF SEPTEMBER 11, 2009. **BASE FLOOD ELEVATION OF 8.00 FEET** (NGVD)
- LAND AREA OF SUBJECT PROPERTY:
FOLIO No. 02-3226-002-0401 = **11,778 SF (+/-)** (CALC.)
FOLIO No. 02-3226-002-0400 = **19,578 SF (+/-)** (CALC.)
- ELEVATIONS ARE BASED ON THE NATIONAL GEODETIC VERTICAL DATUM (NGVD) OF 1929, AS PER MIAMI DADE COUNTY **BENCH MARK No. B-313**, WITH AN ELEVATION OF **4.33 FEET**.
- BEARINGS SHOWN HEREON ARE BASED ON AN ASSUME MERIDIAN OF N06°48'29"W, BEING THE RECORDED BEARING FOR THE CENTERLINE OF PINE TREE DRIVE, AS SHOWN ON PLAT BOOK 10 AT PAGE 3 OF THE PUBLIC RECORD OF MIAMI DADE COUNTY, FLORIDA.

SURVEYOR'S CERTIFICATE:

WE HEREBY CERTIFY THAT THIS BOUNDARY AND TOPOGRAPHICAL SURVEY AND THE SURVEY MAP RESULTING THEREFROM WAS PERFORMED UNDER MY SUPERVISION AND/OR DIRECTION AND IS TRUE AND CORRECT TO THE BEST OF MY KNOWLEDGE AND BELIEF AND FURTHER, THAT SAID "BOUNDARY AND TOPOGRAPHICAL SURVEY" MEETS THE INTENT OF THE APPLICABLE PROVISIONS OF THE "STANDARDS OF PRACTICE FOR LAND SURVEYING IN THE STATE OF FLORIDA", PURSUANT TO RULE 53-17 OF THE FLORIDA ADMINISTRATIVE CODE AND ITS IMPLEMENTING LAW, CHAPTER 472.027 FOR THE FLORIDA STATUTES.

American Services of Miami, Corp.



This item has been digitally signed and sealed by Ed Pino, PSM on the date adjacent to the seal. Printed copies of this document are not considered signed and sealed and the signature must be verified on any electronic copies.

DATE: FEBRUARY 19, 2025

EXISTING TREES INFORMATION:

No.	TREE NAME	BOTANICAL NAME	D.B.H.	HEIGHT	SPREAD
1	MACARTHUR PALM	PTYCHOSPERMA MACARTHU	0.5'	30'	12'
2-4	MACARTHUR PALM	PTYCHOSPERMA MACARTHU	0.5'	30'	12'
5	MACARTHUR PALM	PTYCHOSPERMA MACARTHU	0.4'	35'	10'
6-7	MACARTHUR PALM	PTYCHOSPERMA MACARTHU	0.8'	45'	15'
8-9	ALEXANDER PALM	PTYCHOSPERMA ELEGANS	0.3'	35'	12'
10-11	MACARTHUR PALM	PTYCHOSPERMA MACARTHU	0.5'	35'	15'
12-13	MACARTHUR PALM	PTYCHOSPERMA MACARTHU	0.45'	16'	6'
14	ROYAL PALM	ROYSTONIA ELATA	0.9'	50'	50'
15-16	SABAL DOMINGENSIS	HISPIANIOLA PALMETTO	1.5'	50'	20'
17-19	MACARTHUR PALM	PTYCHOSPERMA MACARTHU	0.4'	25'	12'
20	ALMENDRO	DIPTERYX OLEIFERA	3.0'	80'	80'
21	SILVER BISMARCK PALM	BISMARCKIA NOBILIS	0.4'	15'	6'
22-27	SABAL DOMINGENSIS	HISPIANIOLA PALMETTO	1.75'	50'	30'
28-33	MACARTHUR PALM	PTYCHOSPERMA MACARTHU	0.5'	25'	12'
34	BLACK OAK	QUERCUS VELUTINA	0.8'	50'	40'
35	BLACK OAK	QUERCUS VELUTINA	2.0'	90'	90'
36	MACARTHUR PALM	PTYCHOSPERMA MACARTHU	0.35'	35'	12'
37	SILVER BISMARCK PALM	BISMARCKIA NOBILIS	1.3'	35'	8'
38	CARAMBOLA	AVERRHOA CARAMBOLA	1.3'	15'	20'
39-41	MACARTHUR PALM	PTYCHOSPERMA MACARTHU	0.35'	20'	10'
42	STRANGLER FIG	FICUS AUREA	5.0'	60'	80'
43	STRANGLER FIG	FICUS AUREA	5.0'	60'	80'

CERTIFIED TO:
3500 FLAMINGO DRIVE, LLC
HD FUNDING LLC
OLD REPUBLIC NATIONAL TITLE INSURANCE COMPANY
MELAND BUDWICK, P.A.

ENCROACHMENTS AND OTHER POINTS OF INTEREST:
-THERE NO VISIBLE ENCROACHMENT OF THE SUBJECT PROPERTY
-THE SUBJECT PROPERTY IS WITHIN A FLOOD ZONE AH (SEE NOTE 1)
-THERE ARE UTIL. EASEMENTS WITHIN THE SUBJECT PROPERTY

THIS DRAWING IS THE PROPERTY OF AMERICAN SERVICES OF MIAMI, CORP. AND SHALL NOT BE USED OR REPRODUCED, IN WHOLE, OR IN PART, WITHOUT PERMISSION OF AMERICAN SERVICES OF MIAMI, CORP.

NOTHING HEREON SHALL BE CONSTRUED TO GIVE ANY RIGHTS OR BENEFITS TO ANYONE OTHER THAN THOSE CERTIFIED.

GENERAL SURVEYOR NOTES:

THE SHOWN LEGAL DESCRIPTION USED TO PERFORM THIS BOUNDARY SURVEY WAS PROVIDED BY THE CLIENT. SURVEY IS BASED ON RECORDED INFORMATION PROVIDED BY CLIENT. NO SPECIFIC SEARCH OF THE PUBLIC RECORD HAS BEEN MADE BY OUR OFFICE.

UNLESS OTHERWISE NOTED, AN EXAMINATION OF THE ABSTRACT OF TITLE WAS NOT DONE BY THE SIGNING SURVEYOR TO DETERMINE WHICH INSTRUMENTS, IF ANY ARE AFFECTING THE SUBJECT PROPERTY.

THIS SURVEY IS EXCLUSIVELY FOR THE USE OF THE PARTIES TO WHOM IT WAS CERTIFIED. EXPECTED USE OF LAND IS SUBURBAN, THE MINIMUM RELATIVE DISTANCE ACCURACY FOR THIS TYPE OF SURVEY IS 1 FOOT IN 7,500 FEET. THE ACCURACY OBTAINED BY MEASUREMENT AND CALCULATIONS OF CLOSED GEOMETRIC FIGURES WAS FOUND TO EXCEED THIS REQUIREMENT.

THERE ARE NO VISIBLE, ABOVE GROUND ENCROACHMENTS (a) BY THE IMPROVEMENTS OF THE SUBJECT PROPERTY UPON ADJOINING PROPERTIES, STREETS OR ALLEYS, OR (b) BY THE IMPROVEMENTS OF THE ADJOINING PROPERTIES, STREETS OR ALLEYS UPON THE SUBJECT PROPERTY OTHER THAN THOSE SHOWN ON THIS BOUNDARY SURVEY.

THERE ARE NO VISIBLE EASEMENTS OR RIGHT-OF-WAY OF WHICH THE UNDERSIGNED HAS BEEN ADVISED OTHER THAN THOSE SHOWN ON THIS SURVEY.

THE MAP OF SURVEY IS INTENDED TO BE DISPLAYED AT THE SHOWN GRAPHIC SCALE IN ENGLISH UNITS OF MEASUREMENT. IN SOME CASES GRAPHIC REPRESENTATION HAVE BEEN EXAGGERATED TO MORE CLEARLY ILLUSTRATE A PARTICULAR AREA WHERE DIMENSIONS SHALL HAVE PREFERENCE OVER GRAPHIC LOCATION.

THE ELEVATIONS (IF ANY) OF WELL-IDENTIFIED FEATURES AS DEPICTED ON THIS SURVEY AND MAP WERE MEASURED TO AN ESTIMATED VERTICAL POSITIONAL ACCURACY OF 1/8 FOOT FOR NATURAL GROUND SURFACES AND 1/100 FOOT FOR HARDSCAPE SURFACES, INCLUDING PAVEMENT, CURBS, SIDEWALKS AND OTHER MANMADE STRUCTURES.

THE SURVEYOR MAKES NO REPRESENTATION AS TO OWNERSHIP, POSSESSION OR OCCUPATION OF THE SUBJECT PROPERTY BY ANY ENTITY OR INDIVIDUAL. ANY FEMA FLOOD ZONE INFORMATION PROVIDED ON THIS SURVEY IS FOR INFORMATIONAL PURPOSE ONLY AND IT WAS OBTAINED AT WWW.FEMA.COM.

IF YOU ARE READING THIS BOUNDARY SURVEY IN AN ELECTRONIC FORMAT, THE INFORMATION CONTAINED ON THIS DOCUMENT IS ONLY VALID IF THIS DOCUMENT IS ELECTRONICALLY SIGNED AS SPECIFIED IN CHAPTER 53-17.062 (3) OF THE FLORIDA ADMINISTRATIVE CODE. IF THIS DOCUMENT IS IN PAPER FORMAT, IT IS NOT VALID WITHOUT THE SIGNATURE AND ORIGINAL RAISED SEAL OF THE PROFESSIONAL LAND SURVEYOR AND MAPPER OF RECORD.

This drawing is the property of American Services of Miami, Corp. and shall not be used or reproduced, in whole or in part, without permission of American Services of Miami, Corp.

AMERICAN SERVICES OF MIAMI, CORP.
Consulting Engineers . Planners . Surveyors
266 GIRLIDA AVENUE
CORAL GABLES, FL 33134
PHONE: (305)598-5101 FAX: (305)598-8627
ASOMIAMI.COM

DESIGNED BY: E.P.
CHECKED BY: E.P.
DRAWN BY:
FIELD BOOK No.
PAGE No. 1

ORDER No. 24-430
SHEET No. 1