


Helio Milan
11.22.17

STATE OF FLORIDA
HELIO MILAN ARCHITECT
REGISTRATION NUMBER 0000000000

THESE DESIGNS AND DRAWINGS ARE THE
COPYRIGHTED PROPERTY OF PERMUY
ARCHITECTURE. INTERIOR DESIGN AND
PLANNING, INC. AND MAY NOT BE REPRODUCED
EXCEPT WITH SPECIFIC WRITTEN
CONSENT OF THE ARCHITECT. THE
CONTRACTOR MUST CHECK AND VERIFY ALL
DIMENSIONS OF THE JOB AND BE RESPONSIBLE
FOR SAME. REPORTING ANY DISCREPANCIES TO
THE ARCHITECT BEFORE COMMENCING WORK.
DRAWINGS ARE NOT TO BE SCALED

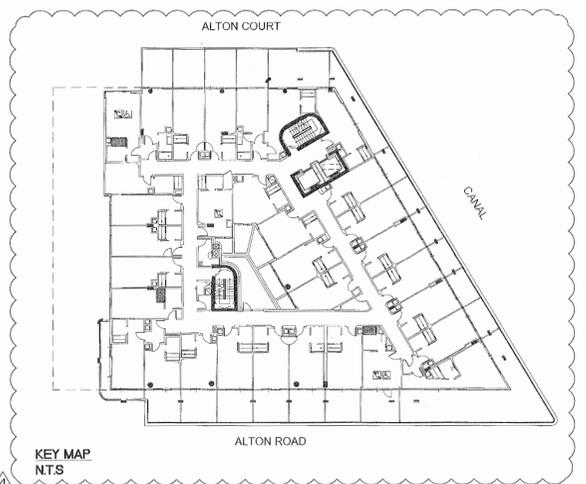

NOTES:
1 - ALL EGRESS DOORS WITH 1/2" MAX ELEVATION. TYPICAL

LIFE SAFETY OCCUPANT LOAD CALCULATION - 3RD-4TH-5TH FLOORS - FBC, TABLE 1004.12

ROOM	FLOOR AREA	OCCUPANT LOAD FACTOR PER 1000 SF	OCCUPANT LOAD	CATEGORY
RESIDENTIAL (HOTEL)	11,191 SF.	200 GROSS	65	HOTEL
MECH/DF/ELEC ROOMS	75 SF.	300 GROSS	1	MECHANICAL RMS
STORAGE/HSKP ROOM	136 SF.	100 GROSS	2	STORAGE
TOTAL -			68 PERSONS	

DOOR AND STAIR EGRESS - 2ND FLOOR - 40 PERSONS

REQUIRED DOOR, 0.2' MIN. WIDTH REQUIRED	REQUIRED STAIR, 0.3' MIN. WIDTH REQUIRED	PROVIDED DOOR, 0.2' MIN. WIDTH REQUIRED	PROVIDED STAIR, 0.3' MIN. WIDTH REQUIRED
8.0' WIDTH	12.0' WIDTH	(2) AT 32" WIDTH	(2) AT 44" WIDTH
TOTAL -		74 PERSONS	

LIFE SAFETY GENERAL NOTES

LEGEND
NOTE: PLANS INDICATE MIN. RATING REQUIRED. ACTUAL WALL MAY HAVE A HIGHER RATING

- 4-4-4 4 HOUR RATED WALL
- 3-3-3 3 HOUR RATED WALL
- 2-2-2 2 HOUR RATED WALL
- 1-1-1 1 HOUR RATED WALL
- 8-8-8 SMOKE BARRIER
- >->-> COMMON PATH OF TRAVEL
- TRAVEL DISTANCE


EXIT LIGHT FIXTURE CEILING MOUNTED. DIRECTION ARROWS AS SHOWN (SHADED QUADRANT INDICATES FACES OF FIXTURE)

EXIT LIGHT FIXTURE WALL MOUNTED. DIRECTION ARROWS AS SHOWN (SHADED QUADRANT INDICATES FACES OF FIXTURE)

MIN. INTERIOR FIN. CLASSIFICATION, TABEL 803.9

GROUP	EXITS	CORRIDORS	OTHER SPACES
A-3	CLASS B	CLASS B	CLASS C
S	CLASS C	CLASS C	CLASS C

NOTES:
ALL EGRESS DOORS WITH 1/2" MAX ELEVATION. TYPICAL

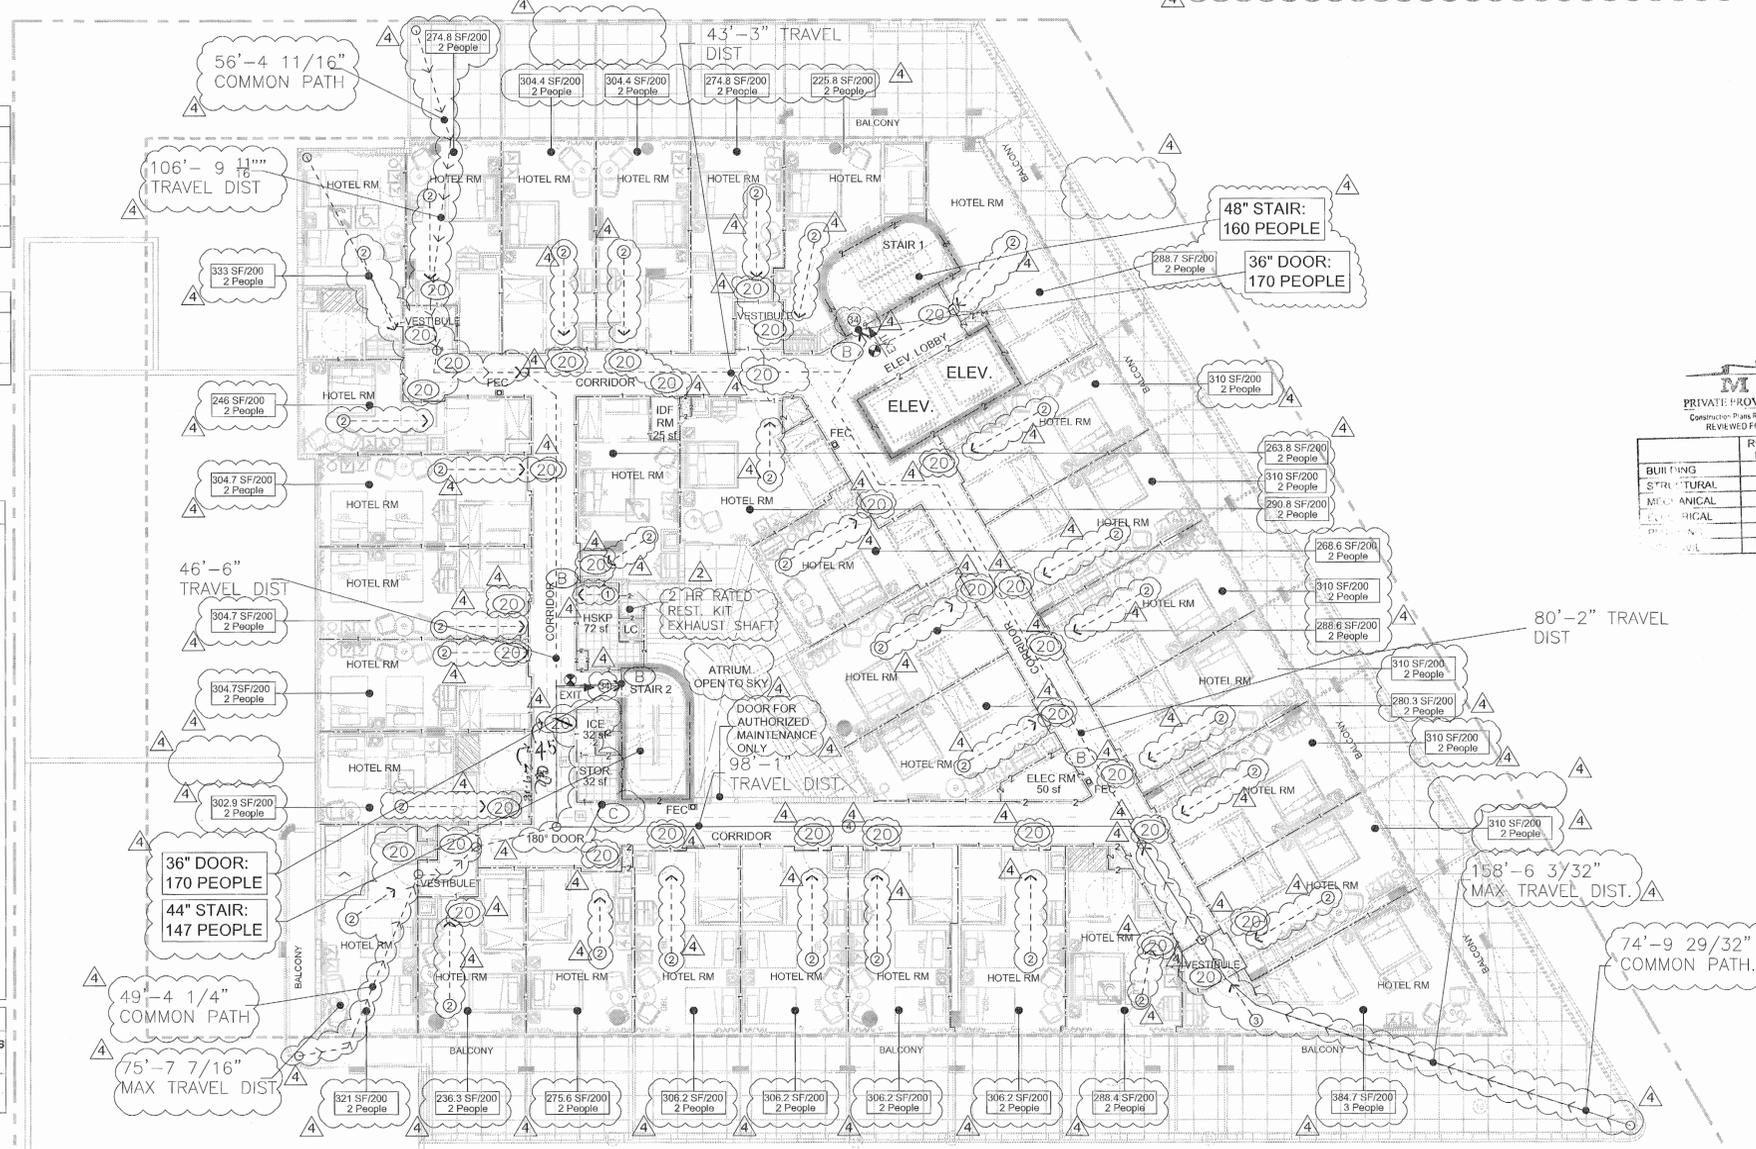

MTCI
PRIVATE PROVIDER SERVICES, LLC
Construction Plans Review, Inspections & Consulting
REGISTERED FOR CODE COMPLIANCE

REVISION	DATE
1	
2	
3	
4	
5	
6	
7	
8	
9	
10	


City of Miami Beach
Fire Prevention Division
PLANS APPROVED

No.	DESCRIPTION	DATE
	PERMIT SET	02.28.17
2	REV. 2	05.31.17
4	REV. 4	11.22.17


PROJECT NO. 1613
DATE: 02.28.17
SHEET INDEX:
SCALE: As Noted
SHEET NO.

Handwritten signature and date: 11.22.17

STATE OF FLORIDA
HELIO MILAN ARCHITECT
REGISTERED ARCHITECT
THESE DESIGNS AND DRAWINGS ARE THE
COPYRIGHTED PROPERTY OF PERMUY
ARCHITECTURE INTERIOR DESIGN AND
PLANNING, INC. AND MAY NOT BE REPRODUCED
EXCEPT WITH SPECIFIC WRITTEN
CONSENT OF THE ARCHITECT. THE
CONTRACTOR MUST CHECK AND VERIFY ALL
DIMENSIONS OF THE JOB AND BE RESPONSIBLE
FOR SAME. REPORTING ANY DISCREPANCIES TO
THE ARCHITECT BEFORE COMMENCING WORK.
DRAWINGS ARE NOT TO BE SCALED

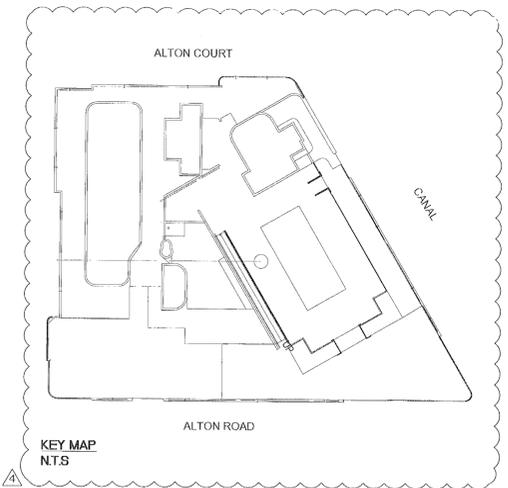

NOTES
ALL EGRESS DOORS WITH 1/2" MAX ELEVATION, TYPICAL

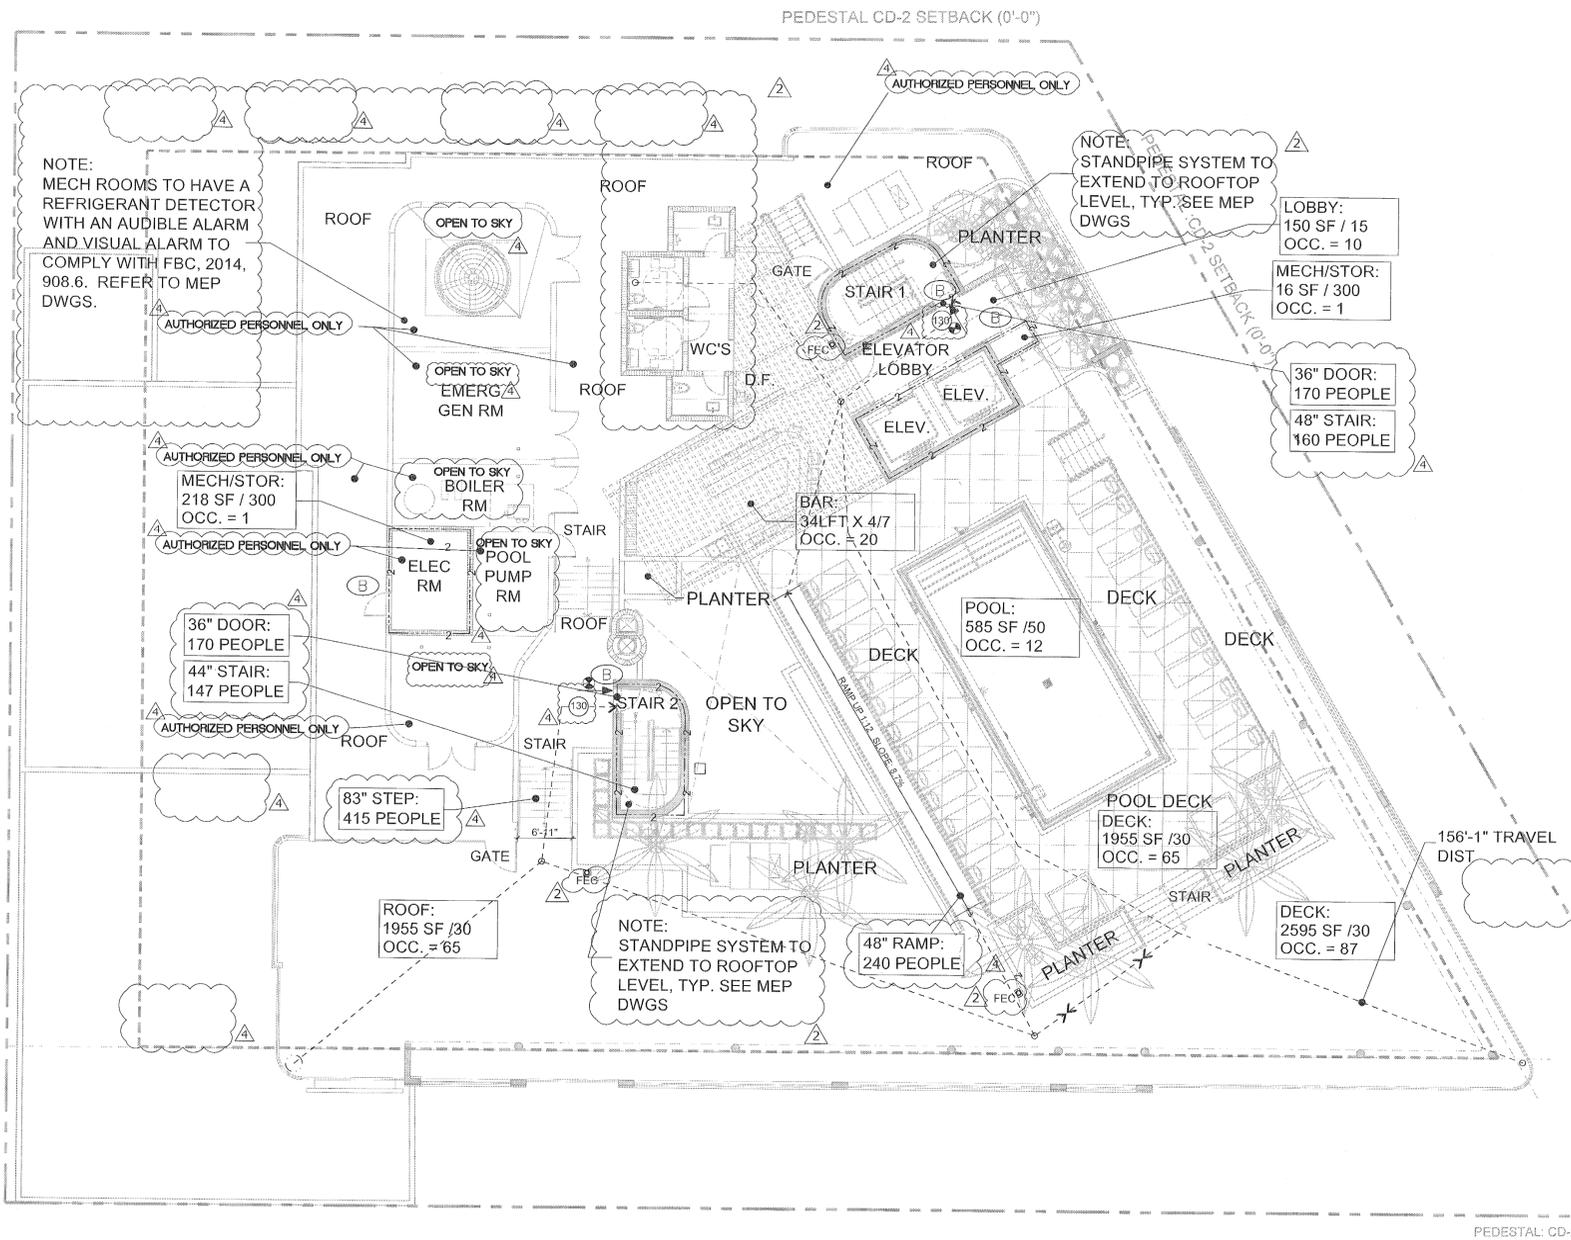

PLUMBING FIXTURE CALCULATION - POOL DECK FLOOR - FBC, TABLE 403.6

ROOM	OCCUPANT LOAD	1/2 MALE	1/2 FEMALE	LAVS
LOBBY	10 PEOPLE	130 PEOPLE	130 PEOPLE	1 PER 200 PERSONS
SWIMMING POOL	12 PEOPLE			
MECH/STOR ROOMS	1 PERSON	2 WCS	2 WCS	2 LAVS
POOL DECK	217 PEOPLE			
BAR	20 PEOPLE			
TOTALS	260 PEOPLE	4 WCS	2 LAVS	

LIFE SAFETY OCCUPANT LOAD CALCULATION - 6TH / POOL DECK FLOOR - FBC, TABLE 1004.12

ROOM	FLOOR AREA	OCCUPANT LOAD FACTOR PER 1,000 SF	OCCUPANT LOAD	CATEGORY
LOBBY	150 SF	15 GROSS	10	LOBBY
POOL	585 SF	50 GROSS	12	POOL SURFACE
MECH/STOR ROOMS	234 SF	300 GROSS	1	STORAGE / MECH
POOL DECK	6505 SF	30 GROSS	217	POOL DECK
BAR	34 LF	4/7 LIN. FEET	20	BAR
		TOTAL =	260 PERSONS	

DOOR AND STAIR EGRESS - 6TH FLOOR / ROOF - 260 PERSONS

REQUIRED DOOR, 0.2' MIN. WIDTH REQUIRED	REQUIRED STAIR, 0.3' MIN. WIDTH REQUIRED	PROVIDED DOOR, 0.2' MIN. WIDTH REQUIRED	STAIR, 0.3' MIN. WIDTH REQUIRED
54.4' WIDTH	81.6' WIDTH	(2) AT 32' WIDTH = 64'	(2) AT 44' WIDTH = 88'
		TOTAL =	260 PERSONS



City of Miami Beach
Fire Prevention Division
PLANS APPROVED



No.	DESCRIPTION	DATE
PERMIT SET		02.28.17
REV. 2		04.28.17
REV. 4		11.22.17

PROJECT NO.	1613
DATE:	02.28.17
SHEET INDEX:	
SCALE:	As Noted
SHEET NO.	

KIMPTON HOTEL
PALOMAR
SOUTH BEACH
1750 Alton Road, Miami Beach, FL 33139
FINVARB GROUP
1065 Kane Concourse, Suite 201, Bay Harbor Island, FL 33154

302 FLOOR OR GROUND SURFACES

302.1 General.
Floor and ground surfaces shall be stable, firm, and slip resistant and shall comply with 302.

EXCEPTIONS:

- Within animal containment areas, floor and ground surfaces shall not be required to be stable, firm, and slip resistant.
- Areas of sport activity shall not be required to comply with 302.

Advisory 302.1 General.

A stable surface is one that remains unchanged by contaminants or applied forces, so that the user is not subjected to a loss of balance or falls. A firm surface is one that does not deform under load. A slip resistant surface is one that provides sufficient frictional counterforce to the forces exerted in walking to prevent a fall.

302.2 Carpet.

Carpet or carpet tile shall be securely attached and shall have a firm cushion, pad, or backing or no cushion or pad. Carpet or carpet tile shall have a level loop, textured loop, level cut pile, or level cut loop pile texture. Carpet or carpet tile shall have a maximum pile height of 1/2 inch (13 mm) maximum. Exposed edges of carpet shall be fastened to floor surfaces and shall have a firm edge on the entire length of the exposed edge. Carpet edge trim shall comply with 303.

Advisory 302.2 Carpet.
Carpet and permanently affixed mats can significantly increase the amount of force (roll resistance) needed to propel a wheelchair over a surface. The firming the carpeting and backing, the lower the roll resistance. A pile thickness up to 1/2 inch (13 mm) (measured to the backing, cushion, or pad) is allowed, although a lower pile provides easier wheelchair backing, cushion, or pad is used, it must be firm. Preferably, carpet pad should not be used because the soft padding increases roll resistance.

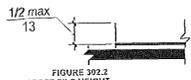


FIGURE 302.2 CARPET PILE HEIGHT

302.3 Openings.

Openings in floor or ground surfaces shall not allow passage of a sphere more than 1/2 inch (13 mm) in diameter except as allowed in 402.2.1, 402.2.3, 402.2.4, 402.2.5, 402.2.99, 402.2.100.

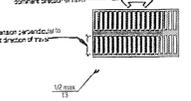


FIGURE 302.3 ELONGATED OPENINGS IN FLOOR OR GROUND SURFACES

303 CHANGES IN LEVEL

303.1 General.
Where changes in level are permitted in floor or ground surfaces, they shall comply with 303.

EXCEPTIONS:

- Animal containment areas shall not be required to comply with 303.
- Areas of sport activity shall not be required to comply with 303.

303.2 Vertical.

Changes in level of 1/4 inch (6.4 mm) high maximum shall be permitted to be vertical.



FIGURE 303.2 VERTICAL CHANGE IN LEVEL

303.3 Beveled.

Changes in level between 1/4 inch (6.4 mm) high maximum and 1/2 inch (13 mm) high maximum shall be beveled with a slope not steeper than 1:2.

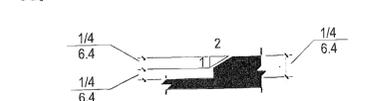


FIGURE 303.3 BEVELED CHANGE IN LEVEL

303.4 Ramps.

Changes in level greater than 1/2 inch (13 mm) high shall be ramped, and shall comply with 405 or 406.

304 TURNING SPACE

304.1 General.
Turning space shall comply with 304.

304.2 Floor or Ground Surfaces.
Floor or ground surfaces of a turning space shall comply with 302. Changes in level are not permitted.

EXCEPTION: Slopes not steeper than 1:48 shall be permitted.

Advisory 304.2 Floor or Ground Surface Exception.
As used in this section, the phrase "changes in level" refers to surfaces with slopes and to surfaces with sport area exceptions that permitted in Section 303.3. Such changes in level are prohibited on required clear floor and ground spaces, turning spaces, and in similar spaces where people using wheelchairs and other mobility devices must park their mobility devices such as wheelchair spaces, or maneuver to use elements such as doors, fixtures, and telephones. This exception permits slopes not steeper than 1:48.

304.3 Size. Turning space shall comply with 304.3.1 or 304.3.2.

304.3.1 Circular Space.
The turning space shall be a space of 60 inches (1525 mm) diameter minimum. The space shall be permitted to provide knee and toe clearance complying with 306.

304.3.2 T-Shaped Space.
The turning space shall be a T-shaped space within a 50 inch (1270 mm) square minimum with arms and base 36 inches (915 mm) wide minimum. Each arm of the T shall be clear of obstructions 12 inches (305 mm) maximum in each direction and the base shall be clear of obstructions 24 inches (610 mm) minimum. The space shall be permitted to include knee and toe clearance complying with 306 only at the end of either the base or one arm.

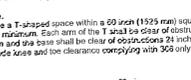


FIGURE 304.3.2 T-SHAPED TURNING SPACE

304.4 Door Swing.
Doors shall be permitted to swing into turning spaces.

305 CLEAR FLOOR OR GROUND SPACE

305.1 General.
Clear floor or ground space shall comply with 305.

305.2 Floor or Ground Surfaces.

Floor or ground surfaces of a clear floor or ground space shall comply with 302. Changes in level are not permitted.

EXCEPTION: Slopes not steeper than 1:48 shall be permitted.

305.3 Size.

The clear floor or ground space shall be 30 inches (760 mm) minimum by 48 inches (1220 mm) minimum.

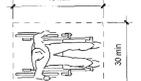


FIGURE 305.3 CLEAR FLOOR OR GROUND SPACE

305.4 Knee and Toe Clearance.

Unless otherwise specified, clear floor or ground space shall be permitted to include knee and toe clearance complying with 306.

305.5 Position.

Unless otherwise specified, clear floor or ground space shall be positioned for either forward or parallel approach to element.



FIGURE 305.5 POSITION OF CLEAR FLOOR OR GROUND SPACE

305.6 Approach.

One full unobstructed side of the clear floor or ground space shall adjoin an accessible route or adjoin another clear floor or ground space.

305.7 Maneuvering Clearance.

Where a clear floor or ground space is located in an alcove or otherwise confined on all or part of three sides, additional maneuvering clearance shall be provided in accordance with 305.7.1 and 305.7.2.

305.7.1 Forward Approach.

Approach shall be 36 inches (915 mm) wide minimum where the depth exceeds 24 inches (610 mm).



FIGURE 305.7.1 MANEUVERING CLEARANCE IN AN ALCOVE, FORWARD APPROACH

305.7.2 Parallel Approach.

Approach shall be 60 inches (1525 mm) wide minimum where the depth exceeds 15 inches (380 mm).

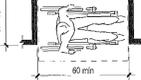


FIGURE 305.7.2 MANEUVERING CLEARANCE IN AN ALCOVE, PARALLEL APPROACH

306 KNEE AND TOE CLEARANCE

306.1 General.
Where space beneath an element is included as part of clear floor or ground space or turning space, the space shall comply with 306. Additional space shall not be prohibited beneath an element but shall not be considered as part of the clear floor or ground space or turning space.

Advisory 306.1 General.
Clearances are measured in relation to the usable clear floor space, not necessarily to the vertical support for an element. When determining clearance under an object for required turning or maneuvering space, care should be taken to ensure the space is clear of any obstructions.

306.2 Toe Clearance.

306.2.1 General.
Space under an element between the finish floor or ground and 9 inches (230 mm) above the finish floor or ground shall be considered toe clearance and shall comply with 306.2.

306.2.2 Maximum Depth.
Toe clearance shall extend 25 inches (635 mm) maximum under an element.

306.2.3 Minimum Required Depth.
Where toe clearance is required at an element as part of a clear floor space, the toe clearance shall extend 17 inches (430 mm) minimum under the element.

306.2.4 Additional Clearance.
Space extending greater than 6 inches (150 mm) beyond the available knee clearance at 9 inches (230 mm) above the finish floor or ground shall not be considered toe clearance.

306.2.5 Width.
Toe clearance shall be 30 inches (760 mm) wide minimum.



FIGURE 306.2 TOE CLEARANCE

306.3 Knee Clearance.

306.3.1 General.
Space under an element between 9 inches (230 mm) and 27 inches (685 mm) above the finish floor or ground shall be considered knee clearance and shall comply with 306.3.

306.3.2 Maximum Depth.
Knee clearance shall extend 25 inches (635 mm) maximum under an element at 9 inches (230 mm) above the finish floor or ground.

306.3.3 Minimum Required Depth.
Where knee clearance is required under an element as part of a clear floor space, the knee clearance shall be 11 inches (280 mm) deep minimum at 9 inches (230 mm) above the finish floor or ground, and 8 inches (205 mm) deep minimum at 27 inches (685 mm) above the finish floor or ground.

306.3.4 Clearance Reduction.
Between 9 inches (230 mm) and 27 inches (685 mm) above the finish floor or ground, the knee clearance shall be permitted to reduce at a rate of 1 inch (25 mm) in depth for each 6 inches (150 mm) in depth.

306.3.5 Width.
Knee clearance shall be 30 inches (760 mm) wide minimum.



FIGURE 306.3 KNEE CLEARANCE

307 PROTRUDING OBJECTS

307.1 General.
Protruding objects shall comply with 307.

307.2 Protrusion Limits.

Objects with leading edges more than 27 inches (685 mm) and not more than 80 inches (2030 mm) above the finish floor or ground shall protrude 4 inches (100 mm) maximum horizontally into the circulation path.

EXCEPTION: Handrails shall be permitted to protrude 41/2 inches (115 mm) maximum.

Advisory 307.2 Protrusion Limits.
When a cane is used and the element is in the detectable range, it gives a person sufficient time to detect the element with the cane before their body contact. Elements located on circulation paths, including operable elements, must comply with requirements for protruding objects. For example, warnings and their supporting structures cannot reduce the minimum required vertical clearance. Similarly, egress windows, when open, cannot encroach more than 4 inches (100 mm) into circulation paths above 27 inches (685 mm).

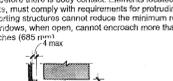


FIGURE 307.2 LIMITS OF PROTRUDING OBJECTS

307.3 Post-Mounted Objects.

Free-standing objects mounted on posts or pylons shall overhang circulation paths 12 inches (305 mm) maximum when located 27 inches (685 mm) minimum and 80 inches (2030 mm) maximum above the finish floor or ground. Where a sign or other obstruction is mounted between posts or pylons and the clear distance between the posts or pylons is greater than 12 inches (305 mm), the lowest edge of such sign or obstruction shall be 27 inches (685 mm) maximum or 80 inches (2030 mm) minimum above the finish floor or ground.

EXCEPTION: The sloping portions of handrails serving stairs and ramps shall not be required to comply with 307.3.

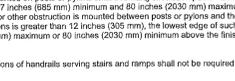


FIGURE 307.3 POST-MOUNTED PROTRUDING OBJECTS

307.4 Vertical Clearance.

Vertical clearance shall be 80 inches (2030 mm) high minimum. Guardsrails or other barriers shall be provided where the vertical clearance is less than 80 inches (2030 mm) high. The leading edge of such guardrail or barrier shall be located 27 inches (685 mm) maximum above the finish floor or ground.

EXCEPTION: Door closers and door stops shall be permitted to be 78 inches (1980 mm) minimum above the finish floor or ground.

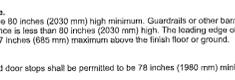


FIGURE 307.4 VERTICAL CLEARANCE

307.5 Required Clear Width.

Protruding objects shall not reduce the clear width required for accessible routes.

308.2 Obstructed High Reach.

Where a clear floor or ground space allows a parallel approach to an element and the high side reach is over an obstruction, the height of the obstruction shall be 34 inches (865 mm) maximum and the depth of the obstruction shall be 24 inches (610 mm) maximum. The high side reach shall be 48 inches (1220 mm) maximum for a reach depth of 10 inches (250 mm) maximum. Where the reach depth exceeds 10 inches (250 mm), the high side reach shall be 46 inches (1170 mm) maximum for a reach depth of 24 inches (610 mm) maximum.

EXCEPTIONS:

- The top of washing machines and clothes dryers shall be permitted to be 36 inches (915 mm) maximum above the finish floor.
- Operable parts of fuel dispensers shall be permitted to be 54 inches (1370 mm) maximum measured from the surface of the vehicular way where fuel dispensers are installed on existing curbs.

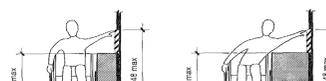


FIGURE 308.2 OBSTRUCTED HIGH SIDE REACH

402 ACCESSIBLE ROUTES

402.1 General.
Accessible routes shall comply with 402.

402.2 Components.
Accessible routes shall consist of one or more of the following components: walking surfaces with a running slope not steeper than 1:20, doorways, ramps, curb ramps including the flared sides, elevators, and platform lifts. All components of an accessible route shall comply with the applicable requirements of Chapter 4 and 206.5.1.

Advisory 402.2 Components.
Walking surfaces must have running slopes not steeper than 1:20, see 403.3. Other components of accessible routes, such as ramps (405) and curb ramps (406), are permitted to be more steeply sloped.

Florida modifications of a 553.5041, F.S., incorporated in section 206.5.1 for access routes to parking that modify requirements of Chapter 4 must be complied with. Pursuant to 553.512, F.S., Florida requirements, except a 553.5041(9)(b) width of accessible route tapering and a 553.5041(1) parking space and access aisle width, may be waived down to the requirements of the ADA Standards for Accessible Design.

402.3 Components.
Accessible routes shall consist of one or more of the following components: walking surfaces with a running slope not steeper than 1:20, doorways, ramps, curb ramps including the flared sides, elevators, and platform lifts. All components of an accessible route shall comply with the applicable requirements of Chapter 4 and 206.5.1.

Advisory 402.3 Components.
Walking surfaces must have running slopes not steeper than 1:20, see 403.3. Other components of accessible routes, such as ramps (405) and curb ramps (406), are permitted to be more steeply sloped.

Florida modifications of a 553.5041, F.S., incorporated in section 206.5.1 for access routes to parking that modify requirements of Chapter 4 must be complied with. Pursuant to 553.512, F.S., Florida requirements, except a 553.5041(9)(b) width of accessible route tapering and a 553.5041(1) parking space and access aisle width, may be waived down to the requirements of the ADA Standards for Accessible Design.

402.4 Components.
Accessible routes shall consist of one or more of the following components: walking surfaces with a running slope not steeper than 1:20, doorways, ramps, curb ramps including the flared sides, elevators, and platform lifts. All components of an accessible route shall comply with the applicable requirements of Chapter 4 and 206.5.1.

Advisory 402.4 Components.
Walking surfaces must have running slopes not steeper than 1:20, see 403.3. Other components of accessible routes, such as ramps (405) and curb ramps (406), are permitted to be more steeply sloped.

Florida modifications of a 553.5041, F.S., incorporated in section 206.5.1 for access routes to parking that modify requirements of Chapter 4 must be complied with. Pursuant to 553.512, F.S., Florida requirements, except a 553.5041(9)(b) width of accessible route tapering and a 553.5041(1) parking space and access aisle width, may be waived down to the requirements of the ADA Standards for Accessible Design.

402.5 Components.
Accessible routes shall consist of one or more of the following components: walking surfaces with a running slope not steeper than 1:20, doorways, ramps, curb ramps including the flared sides, elevators, and platform lifts. All components of an accessible route shall comply with the applicable requirements of Chapter 4 and 206.5.1.

Advisory 402.5 Components.
Walking surfaces must have running slopes not steeper than 1:20, see 403.3. Other components of accessible routes, such as ramps (405) and curb ramps (406), are permitted to be more steeply sloped.

Florida modifications of a 553.5041, F.S., incorporated in section 206.5.1 for access routes to parking that modify requirements of Chapter 4 must be complied with. Pursuant to 553.512, F.S., Florida requirements, except a 553.5041(9)(b) width of accessible route tapering and a 553.5041(1) parking space and access aisle width, may be waived down to the requirements of the ADA Standards for Accessible Design.

402.6 Components.
Accessible routes shall consist of one or more of the following components: walking surfaces with a running slope not steeper than 1:20, doorways, ramps, curb ramps including the flared sides, elevators, and platform lifts. All components of an accessible route shall comply with the applicable requirements of Chapter 4 and 206.5.1.

Advisory 402.6 Components.
Walking surfaces must have running slopes not steeper than 1:20, see 403.3. Other components of accessible routes, such as ramps (405) and curb ramps (406), are permitted to be more steeply sloped.

Florida modifications of a 553.5041, F.S., incorporated in section 206.5.1 for access routes to parking that modify requirements of Chapter 4 must be complied with. Pursuant to 553.512, F.S., Florida requirements, except a 553.5041(9)(b) width of accessible route tapering and a 553.5041(1) parking space and access aisle width, may be waived down to the requirements of the ADA Standards for Accessible Design.

402.7 Components.
Accessible routes shall consist of one or more of the following components: walking surfaces with a running slope not steeper than 1:20, doorways, ramps, curb ramps including the flared sides, elevators, and platform lifts. All components of an accessible route shall comply with the applicable requirements of Chapter 4 and 206.5.1.

Advisory 402.7 Components.
Walking surfaces must have running slopes not steeper than 1:20, see 403.3. Other components of accessible routes, such as ramps (405) and curb ramps (406), are permitted to be more steeply sloped.

Florida modifications of a 553.5041, F.S., incorporated in section 206.5.1 for access routes to parking that modify requirements of Chapter 4 must be complied with. Pursuant to 553.512, F.S., Florida requirements, except a 553.5041(9)(b) width of accessible route tapering and a 553.5041(1) parking space and access aisle width, may be waived down to the requirements of the ADA Standards for Accessible Design.

402.8 Components.
Accessible routes shall consist of one or more of the following components: walking surfaces with a running slope not steeper than 1:20, doorways, ramps, curb ramps including the flared sides, elevators, and platform lifts. All components of an accessible route shall comply with the applicable requirements of Chapter 4 and 206.5.1.

Advisory 402.8 Components.
Walking surfaces must have running slopes not steeper than 1:20, see 403.3. Other components of accessible routes, such as ramps (405) and curb ramps (406), are permitted to be more steeply sloped.

Florida modifications of a 553.5041, F.S., incorporated in section 206.5.1 for access routes to parking that modify requirements of Chapter 4 must be complied with. Pursuant to 553.512, F.S., Florida requirements, except a 553.5041(9)(b) width of accessible route tapering and a 553.5041(1) parking space and access aisle width, may be waived down to the requirements of the ADA Standards for Accessible Design.

402.9 Components.
Accessible routes shall consist of one or more of the following components: walking surfaces with a running slope not steeper than 1:20, doorways, ramps, curb ramps including the flared sides, elevators, and platform lifts. All components of an accessible route shall comply with the applicable requirements of Chapter 4 and 206.5.1.

Advisory 402.9 Components.
Walking surfaces must have running slopes not steeper than 1:20, see 403.3. Other components of accessible routes, such as ramps (405) and curb ramps (406), are permitted to be more steeply sloped.

Florida modifications of a 553.5041, F.S., incorporated in section 206.5.1 for access routes to parking that modify requirements of Chapter 4 must be complied with. Pursuant to 553.512, F.S., Florida requirements, except a 553.5041(9)(b) width of accessible route tapering and a 553.5041(1) parking space and access aisle width, may be waived down to the requirements of the ADA Standards for Accessible Design.


402.10 Components.
Accessible routes shall consist of one or more of the following components: walking surfaces with a running slope not steeper than

404.2.4.2 Doorways without Doors or Gates, Sliding Doors, and Folding Doors.
Doorways less than 36 inches (915 mm) wide without doors or gates, sliding doors, or folding doors shall have maneuvering clearances complying with Table 404.2.4.2.

**TABLE 404.2.4.2
MANEUVERING CLEARANCES AT DOORWAYS WITHOUT DOORS OR GATES,
MANUAL SLIDING DOORS, AND MANUAL FOLDING DOORS**

Approach Direction	Minimum Maneuvering Clearance	
	Perpendicular to Doorway	Parallel to Doorway (beyond stoop/step side unless noted)
From Front	48 inches (1220 mm)	0 inches (0 mm)
From Side	42 inches (1065 mm)	0 inches (0 mm)
From pocket/hinge side from stoop/step side	42 inches (1065 mm)	22 inches (560 mm) 2
		24 inches (610 mm)


1. Doorway with no door only.
2. Beyond pocket/hinge side.

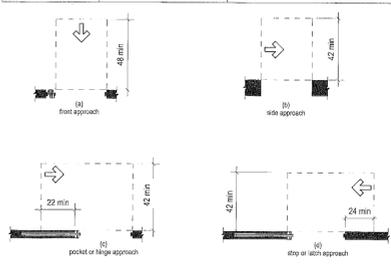

**FIGURE 404.2.4.2
MANEUVERING CLEARANCES AT DOORWAYS WITHOUT DOORS, SLIDING DOORS, GATES, AND FOLDING DOORS**

404.2.4.3 Recessed Doors and Gates.
Maneuvering clearances for forward approach shall be provided when any obstruction within 18 inches (457 mm) of the latch side of a doorway projects more than 3 inches (76 mm) beyond the face of the door, measured perpendicular to the face of the door or gate.

Advisory 404.2.4.3 Recessed Doors and Gates.
A door can be recessed due to wall thickness or because of the placement of casework and other fixed elements adjacent to the doorway. This provision must be applied whenever doors are recessed.

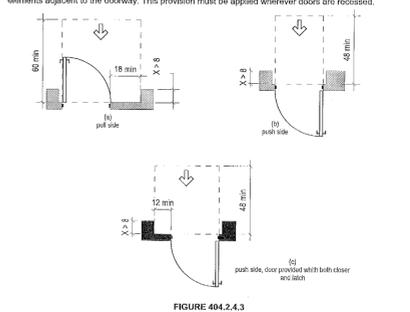

**FIGURE 404.2.4.3
MANEUVERING CLEARANCES AT RECESSED DOORS AND GATES**


404.2.4.4 Floor or Ground Surface.
Floor or ground surface within required maneuvering clearances shall comply with 302. Changes in level are not permitted.

- EXCEPTIONS:**
- Slopes not steeper than 1:48 shall be permitted.
 - Changes in level at thresholds complying with 404.2.5 shall be permitted.

404.2.5 Thresholds.
Thresholds, if provided at doorways, shall be 1/2 inch (13 mm) high maximum. Raised thresholds and changes in level at doorways shall comply with 302 and 303.

EXCEPTION:
Existing or altered thresholds 3/4 inch (19 mm) high maximum that have a beveled edge on each side with a slope not steeper than 1:12 shall be required to comply with 404.2.5.

404.2.6 Doors in Series and Gates in Series.
The distance between two hinged or pivoted doors in series and gates in series shall be 48 inches (1220 mm) minimum plus the width of the doors or gates swinging into the space.

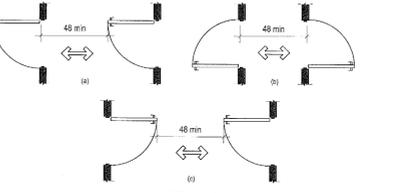

**FIGURE 404.2.6
DOORS IN SERIES AND GATES IN SERIES**

404.2.7 Door and Gate Hardware.
Handles, pulls, latches, locks, and other operable parts on doors and gates shall comply with 309.4. Operable parts of such hardware shall be 34 inches (863 mm) minimum and 43 inches (1220 mm) maximum above the finish floor or ground. Where sliding doors are in the fully open position, operating hardware shall be exposed and usable from both sides.

EXCEPTIONS:

- Existing locks shall be permitted in any location at existing glazed doors without sills, existing overhead rolling doors or grilles, and similar existing doors or grilles that are designed with locks that are activated only at the top or bottom rail.
- Access gates in barrier walls and fences protecting pools, spas, and hot tubs shall be permitted to have operable parts of the release of latch self-latching devices at 54 inches (1370 mm) maximum above the finish floor or ground provided the self-latching devices are not also self-locking devices and operated by means of a key, electronic opener, or integral combination lock.

Advisory 404.2.7 Door and Gate Hardware.
Door hardware that can be operated with a closed fist or a loose grip accommodates the greatest range of users. Hardware that requires simultaneous hand and finger movements require greater dexterity and coordination, and is not recommended.

404.2.8 Closing Speed.
Door and gate closing speed shall comply with 404.2.8.

404.2.8.1 Door Closers and Gate Closers.
Door closers and gate closers shall be adjusted so that from an open position of 90 degrees, the time required to move the door to a position of 12 degrees from the latch is 5 seconds minimum.

404.2.8.2 Spring Hinge.
Door and gate spring hinges shall be adjusted so that from the open position of 70 degrees, the door or gate shall move to the closed position in 1.5 seconds minimum.

404.2.9 Door and Gate Opening Force.
Fire doors shall have a minimum opening force allowable by the appropriate administrative authority. The force for pushing or pulling open a door or gate other than fire doors shall be as follows:

- Inferior hinged doors and gates: 5 pounds (22.2 N) maximum.
- Sliding or folding doors: 6 pounds (22.2 N) maximum.
- Exterior hinged doors shall be designed so that such doors can be pushed or pulled open with force not exceeding 8.5 pounds (37.8 N).

These forces do not apply to the force required to retract latch bolts or disengage other devices that hold the door or gate in a closed position.

Advisory 404.2.9 Door and Gate Opening Force.
The maximum force pertains to the continuous application of force necessary to fully open a door, not the initial force needed to overcome the inertia of the door. It does not apply to the force required to retract bolts or to disengage other devices used to keep the door in closed position.

Florida law, s.553.994(6), F.S., establishes requirements for exterior door opening force.

404.2.10 Door and Gate Surfaces.
Swinging door and gate surfaces within 10 inches (255 mm) of the finish floor or ground measured vertically shall have a smooth surface on the push side extending the full width of the door or gate. This includes horizontal or vertical joints in these surfaces shall be within 1/16 inch (1.6 mm) of the same plane as the other. Cavities created by added kick plates shall be capped.

- EXCEPTIONS:**
- Sliding doors shall not be required to comply with 404.2.10.
 - Tempered glass doors without sills and having a bottom rail or shoe with the top edge tapered at 60 degrees minimum from the horizontal shall not be required to meet the 10 inch (255 mm) bottom smooth surface height requirement.
 - Doors and gates that do not extend to within 10 inches (255 mm) of the finish floor or ground shall not be required to comply with 404.2.10.
 - Existing doors and gates without smooth surfaces within 10 inches (255 mm) of the floor or ground shall not be required to provide smooth surfaces complying with provided that added kick plates are installed, cavities created by such kick plates are capped.

404.2.11 Vision Lights.
Doors, gates, and side lights adjacent to doors or gates, containing one or more glazed panels that permit viewing through the panels shall have the bottom of at least one glazed panel located 43 inches (1090 mm) maximum above the finish floor.

EXCEPTION:
Vision lights with the lowest part more than 56 inches (1675 mm) from the finish floor or ground shall not be required to comply with 404.2.11.

404.3 Automatic and Power-Assisted Doors and Gates.
Automatic doors and automatic gates shall comply with 404.3. Full-powered automatic doors shall comply with ANSI/HFMA A156.10 (incorporated by reference, see "Referenced Standards" in Chapter 1). Low-energy and power-assisted doors shall comply with ANSI/HFMA A156.19 (1997 or 2002 edition) (incorporated by reference, see "Referenced Standards" in Chapter 1).

404.3.1 Clear Width.
Doorways shall provide a clear opening of 32 inches (815 mm) minimum in power-on and power-off mode. The minimum clear width for automatic door systems in a doorway shall be based on the clear opening provided by all leaves in the open position.

404.3.2 Maneuvering Clearances.
Clearances at power-assisted doors and gates shall comply with 404.2.4. Clearances at automatic doors and gates without standby power and serving an accessible means of egress shall comply with 404.2.4.

EXCEPTION:
Where automatic doors and gates remain open in the power-off condition, compliance with 404.2.4 shall not be required.

404.3.3 Threshold.
Thresholds and changes in level at doorways shall comply with 404.2.5.

404.3.4 Doors in Series and Gates in Series.
Doors in series and gates in series shall comply with 404.2.6.

404.3.5 Controls.
Manually operated controls shall comply with 308. The clear floor space adjacent to the control shall be located beyond the arc of the door swing.

404.3.6 Break Out Opening.
Where doors and gates without standby power are a part of a means of egress, the clear break out opening at swinging or sliding doors and gates shall be 32 inches (815 mm) minimum when operated in emergency mode.

EXCEPTION:
Where manual swinging doors and gates comply with 404.2 and serve the same means of egress compliance with 404.3.6 shall not be required.

404.3.7 Revolving Doors, Revolving Gates, and Turns.
Revolving doors, revolving gates, and turnstiles shall not be part of an accessible route.

405 RAMPS.
Ramps on accessible routes shall comply with 405.

405.1 General.
The clear floor or ground surface shall be firm, stable, and slip resistant. Ramps shall be constructed so that they are accessible to and usable by those people they are intended to benefit. Building owners should note that the ASME Safety Code for Elevators and Escalators requires routine maintenance and inspections. Isolated or temporary interruptions in service due to maintenance or repairs may be unavoidable; however, failure to take prompt action to effect repairs could constitute a violation of Federal laws and those requirements.

EXCEPTION:
In assembly areas, aisles remain adjacent to seating and not serve elements required to be on an accessible route shall not be required to comply with 405.

405.2 Slope.
Ramp runs shall have a running slope not steeper than 1:12.

EXCEPTION:
In existing sites, buildings, and facilities, ramps shall be permitted to have running slopes steeper than 1:12 complying with Table 405.2 where such slopes are necessary due to space limitations.

Advisory 405.2 Slope.
To accommodate the widest range of users, provide ramps with the least possible running slope and, wherever possible, accompany ramps with stairs for use by those individuals for whom distance presents a greater barrier than slope, e.g., people with heart disease or limited stamina.

**TABLE 405.2
MAXIMUM RAMP SLOPE AND RISE FOR EXISTING SITES, BUILDINGS, AND FACILITIES**

Slope	Maximum Rise
Steeper than 1:10 but not steeper than 1:8	3 inches (75 mm)
Steeper than 1:12 but not steeper than 1:10	8 inches (150 mm)

1. A slope steeper than 1:8 is prohibited.

405.3 Cross Slope.
Cross slope of ramp runs shall not be steeper than 1:48.

Advisory 405.3 Cross Slope.
Cross slope is the slope of the surface perpendicular to the direction of travel. Cross slope is measured the same way as slope is measured (i.e., the rise over the run).

405.4 Floor or Ground Surfaces.
Floor or ground surfaces of ramp runs shall comply with 302. Changes in level other than the running slope and cross slope are not permitted on ramps.


405.5 Clear Width.
The clear width of a ramp run and, where handrails are provided, the clear width between handrails shall be 36 inches (915 mm) minimum.

EXCEPTION:
Within employee work areas, the required clear width of ramps that are a part of common use circulation paths shall be permitted to be decreased by work area equipment provided that the decrease is essential to the function of the work being performed.

405.6 Rise.
The rise for any ramp run shall be 30 inches (760 mm) maximum.

405.7 Landings.
Ramps shall have landings at the top and the bottom of each ramp run. Landings shall comply with 405.7.

Advisory 405.7 Landings.
Ramps that do not have level landings at changes in direction can create a compound slope that will not meet the requirements of this code. Circular or curved ramps continually change direction. Curvilinear ramps with small radii also can create compound cross slopes and cannot, by their nature, meet the requirements for accessible routes. A level landing is needed at the accessible door to permit maneuvering and simultaneous door operation.

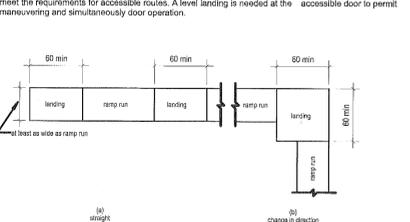

**FIGURE 405.7
RAMP LANDINGS**

405.7.1 Slope.
Landings shall comply with 302. Changes in level are not permitted.

EXCEPTION:
Slopes not steeper than 1:48 shall be permitted.

405.7.2 Width.
The landing clear width shall be at least as wide as the widest ramp run leading to the landing.

405.7.3 Length.
The landing clear length shall be 60 inches (1525 mm) long minimum.

405.7.4 Change in Direction.
Ramps that change direction between runs at landings shall have a clear landing 60 inches (1525 mm) long.

405.7.5 Doorways.
Where doorways are located adjacent to a ramp landing, maneuvering clearances required by 404.2.4 and 404.3.2 shall be permitted to overlap the required landing area.

405.8 Handrails.
Ramp runs with a rise greater than 6 inches (150 mm) shall have handrails complying with 505.

EXCEPTION:
Within employee work areas, handrails shall not be required where ramps are part of common use circulation paths are designed to permit the installation of handrails complying with 505. Ramps not subject to the exception to 405.5 shall be designed to maintain a 36 inch (915 mm) minimum clear width when handrails are installed.


405.9 Edge Protection.
Edge protection complying with 405.9.1 or 405.9.2 shall be provided on each side of ramp runs and at each side of ramp landings.

EXCEPTIONS:

- Edge protection shall not be required on ramps that are not required to have handrails and have slopes complying with 408.3.
- Edge protection shall not be required on the sides of ramp landings serving an adjoining ramp.
- Edge protection shall not be required on the sides of ramp landings having a vertical drop-off of 12 inch (31 mm) maximum within 10 inches (255 mm) horizontally of the minimum landing area.


405.9.1 Extended Floor or Ground Surface.
The floor or ground surface of the ramp run or landing shall extend 12 inches (305 mm) minimum beyond the inside face of a handrail complying with 505.

Advisory 405.9.1 Extended Floor or Ground Surface.
The extended surface prevents wheelchair casters and crutch tips from slipping off the ramp surface.

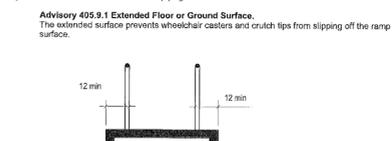

**FIGURE 405.9.1
EXTENDED FLOOR OR GROUND SURFACE EDGE PROTECTION**

405.9.2 Curb or Barrier.
A curb or barrier shall be provided that prevents the passage of a 4 inch (100 mm) diameter sphere, where any portion of the sphere is within 4 inches (100 mm) of the finish floor or ground surface.

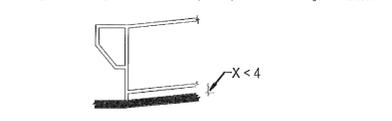

**FIGURE 405.9.2
CURB OR BARRIER EDGE PROTECTION**

405.10 Wet Conditions.
Landings subject to wet conditions shall be designed to prevent the accumulation of water.

406 CURB RAMPS.
Curb ramps on accessible routes shall comply with 406, 405.2 through 405.5, and 405.10.

406.1 General.
Curb ramps on accessible routes shall comply with 406, 405.2 through 405.5, and 405.10.

406.2 Counter Slope.
Counter slopes of adjoining gutters and road surfaces immediately adjacent to the curb ramp shall not be steeper than 1:20. The adjacent surfaces at transitions at curb ramps to walks, gutters, and streets shall be at the same level.

406.2.1 Call Controls.
Call buttons and keypads shall be permitted to have recessed call buttons.

EXCEPTION:
Existing elevators shall be permitted to have recessed call buttons.

407.2.1.1 Height.
Call buttons and keypads shall be located within one of the reach ranges specified in 308, measured to the centerline of the highest operable part.

EXCEPTION:
Existing call buttons and existing keypads shall be permitted to be located at 54 inches (1370 mm) maximum above the finish floor, measured to the centerline of the highest operable part.

407.2.1.2 Size.
Call buttons shall be 3/4 inch (19 mm) minimum in the smallest dimension.

EXCEPTION:
Existing elevator call buttons shall not be required to comply with 407.2.1.2.

407.2.1.3 Clear Floor or Ground Space.
A clear floor or ground space complying with 305 shall be provided at call controls.

Advisory 407.2.1.3 Clear Floor or Ground Space.
The clear floor or ground space required at elevator call buttons must remain free of obstructions including ashtrays, plants, and other decorative elements that prevent wheelchair users and others from reaching the call buttons. The height of the clear floor or ground space is considered to be a volume from the floor to 80 inches (2030 mm) above the floor. Recessed ashtrays should not be placed near elevator call buttons so that persons who are blind or visually impaired do not inadvertently contact them or their contents as they reach for the call buttons.

407.2.1.4 Location.
The call button that designates the up direction shall be located above the call button that designates the down direction.

EXCEPTION:
Destination-oriented elevators shall not be required to comply with 407.2.1.4.

Advisory 407.2.1.4 Location Exception.
A destination-oriented elevator system provides lobby controls enabling passengers to select floor stops, lobby indicators designating which elevator to use, and a car indicator designating the floors at which the car will stop. Responding cars are programmed for maximum efficiency by reducing the number of stops any passenger experiences.

407.2.1.5 Signals.
Call buttons shall have visible signals to indicate when each call is registered and when each call is answered.

EXCEPTIONS:

- Destination-oriented elevators shall not be required to comply with 407.2.1.5 provided that visible and audible signals complying with 407.2.2 indicating which elevator car to enter are provided.
- Existing elevators shall not be required to comply with 407.2.1.5.

407.2.1.6 Keypads.
Where keypads are provided, keypads shall be in a standard telephone keypad arrangement and shall comply with 407.4.2.2.

407.2.2 Hall Signals.
Hall signals, including in-car signals, shall comply with 407.2.2.

407.2.2.1 Visible and Audible Signals.
A visible and audible signal shall be provided at each hoistway entrance to indicate which car is answering a call and the car's direction of travel. Where in-car signals are provided, they shall be visible from the floor area adjacent to the hall call buttons.

EXCEPTIONS:

- Visible and audible signals shall not be required at each destination-oriented elevator where a visible and audible signal complying with 407.2.2 is provided indicating the elevator car designation information.
- In existing elevators, a signal indicating the direction of car travel shall not be required.

407.2.2.2 Visible Signals.
Visible signal fixtures shall be centered at 72 inches (1830 mm) minimum above the finish floor or ground. The visible signal elements shall be 2 1/2 inches (64 mm) minimum measured along the vertical centerline of the element. Signals shall be visible from the floor area adjacent to the hall call button.

EXCEPTIONS:

- Destination-oriented elevators shall be permitted to have signals visible from the floor area adjacent to the hoistway entrance.
- Existing elevators shall not be required to comply with 407.2.2.2.

407.2.2.3 Audible Signals.
Audible signals shall sound once for the up direction and twice for the down direction, or shall have verbal announcements that indicate the direction of elevator car travel. Audible signals shall have a frequency of 1500 Hz maximum. Verbal announcements shall have a frequency of 300 Hz minimum and 3000 Hz maximum. The audible signal and verbal annunciator shall be 10 dB minimum above ambient, but shall not exceed 90 dB, measured at the hall call button.

EXCEPTIONS:

- Destination-oriented elevators shall not be required to comply with 407.2.2.3 provided that the audible tone and verbal announcement is the same as those given at the call button or call button keypad.
- Existing elevators shall not be required to comply with the requirements for frequency and dB range of audible signals.

407.2.2.4 Differentiation.
Each destination-oriented elevator in a bank of elevators shall have audible and visible means for differentiation.

407.2.3 Hoistway Signs.
Signs at elevator hoistways shall comply with 407.2.3.

407.2.3.1 Floor Designation.
Floor designations complying with 703.2 and 703.4.1 shall be provided on both jambs of elevator hoistway entrances. Floor designations shall be provided in both tactile characters and braille. Tactile characters shall be 2 inches (51 mm) high minimum. A tactile star shall be provided on both jambs at the main entry level.

407.2.3.2 Floor Designation.
Floor designations complying with 703.2 and 703.4.1 shall be provided on both jambs of elevator hoistway entrances. Floor designations shall be provided in both tactile characters and braille. Tactile characters shall be 2 inches (51 mm) high minimum. A tactile star shall be provided on both jambs at the main entry level.

407.2.3.3 Floor Designation.
Floor designations complying with 703.2 and 703.4.1 shall be provided on both jambs of elevator hoistway entrances. Floor designations shall be provided in both tactile characters and braille. Tactile characters shall be 2 inches (51 mm) high minimum. A tactile star shall be provided on both jambs at the main entry level.


407.2.3.4 Floor Designation.
Floor designations complying with 703.2 and 703.4.1 shall be provided on both jambs of elevator hoistway entrances. Floor designations shall be provided in both tactile characters and braille. Tactile characters shall be 2 inches (51 mm) high minimum. A tactile star shall be provided on both jambs at the main entry level.

407.2.3.5 Floor Designation.
Floor designations complying with 703.2 and 703.4.1 shall be provided on both jambs of elevator hoistway entrances. Floor designations shall be provided in both tactile characters and braille. Tactile characters shall be 2 inches (51 mm) high minimum. A tactile star shall be provided on both jambs at the main entry level.

407.2.3.6 Floor Designation.
Floor designations complying with 703.2 and 703.4.1 shall be provided on both jambs of elevator hoistway entrances. Floor designations shall be provided in both tactile characters and braille. Tactile characters shall be 2 inches (51 mm) high minimum. A tactile star shall be provided on both jambs at the main entry level.

407.2.3.7 Floor Designation.
Floor designations complying with 703.2 and 703.4.1 shall be provided on both jambs of elevator hoistway entrances. Floor designations shall be provided in both tactile characters and braille. Tactile characters shall be 2 inches (51 mm) high minimum. A tactile star shall be provided on both jambs at the main entry level.

406.8 Detectable Warnings.
Curb ramps subject to Department of Transportation regulation 49 CFR 97.21 shall have a detectable warning complying with 505. The detectable warning shall extend the full width of the curb ramp (inclusive of flared sides) and shall extend either the full depth of the curb ramp or 24 inches (610 mm) deep minimum measured from the back of the curb on the ramp surface.

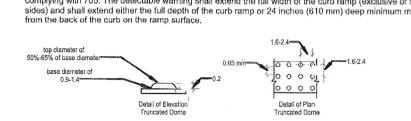

**FIGURE 406.8
DETECTABLE WARNINGS AT CURB RAMPS SUBJECT TO DOT REGULATION 49 CFR 97.21**

407 ELEVATORS.
Elevators shall comply with 407 and ASME A17.1 (incorporated by reference, see "Referenced Standards" in Chapter 1). They shall be passenger elevators as classified by ASME A17.1. Elevator operation shall be automatic.

Advisory 407.1 General.
The ADA and other Federal civil rights laws require that accessible features be maintained in working order so that they are accessible to and usable by those people they are intended to benefit. Building owners should note that the ASME Safety Code for Elevators and Escalators requires routine maintenance and inspections. Isolated or temporary interruptions in service due to maintenance or repairs may be unavoidable; however, failure to take prompt action to effect repairs could constitute a violation of Federal laws and those requirements.

407.1 General.
Elevators shall comply with 407 and ASME A17.1 (incorporated by reference, see "Referenced Standards" in Chapter 1). They shall be passenger elevators as classified by ASME A17.1. Elevator operation shall be automatic.

407.2 Elevator Landing Requirements.
Elevator landings shall comply with 407.2.

407.2.1 Call Controls.
Where elevator call buttons or keypads are provided, they shall comply with 407.2.1 and 309.4. Call buttons shall be raised or flush.

EXCEPTION:
Existing elevators shall be permitted to have recessed call buttons.

407.2.1.1 Height.
Call buttons and keypads shall be located within one of the reach ranges specified in 308, measured to the centerline of the highest operable part.

EXCEPTION:
Existing call buttons and existing keypads shall be permitted to be located at 54 inches (1370 mm) maximum above the finish floor, measured to the centerline of the highest operable part.

407.2.1.2 Size.
Call buttons shall be 3/4 inch (19 mm) minimum in the smallest dimension.

EXCEPTION:
Existing elevator call buttons shall not be required to comply with 407.2.1.2.

407.2.1.3 Clear Floor or Ground Space.
A clear floor or ground space complying with 305 shall be provided at call controls.

Advisory 407.2.1.3 Clear Floor or Ground Space.
The clear floor or ground space required at elevator call buttons must remain free of obstructions including ashtrays, plants, and other decorative elements that prevent wheelchair users and others from reaching the call buttons. The height of the clear floor or ground space is considered to be a volume from the floor to 80 inches (2030 mm) above the floor. Recessed ashtrays should not be placed near elevator call buttons so that persons who are blind or visually impaired do not inadvertently contact them or their contents as they reach for the call buttons.

407.2.1.4 Location.
The call button that designates the up direction shall be located above the call button that designates the down direction.

EXCEPTION:
Destination-oriented elevators shall not be required to comply with 407.2.1.4.

407.4.6 Elevator Car Controls.
Where provided, elevator car controls shall comply with 407.4.6 and 309.4.

EXCEPTION In existing elevators, where a new car operating panel complying with 407.4.6 is provided, existing car operating panels shall not be required to comply with 407.4.6.

407.4.6.1 Location.
Controls shall be located within one of the reach ranges specified in 309.

EXCEPTIONS:
1. Where the elevator panel serves more than 15 operations and a parallel approach is provided, buttons with floor designations shall be permitted to be 54 inches (1370 mm) maximum above the finish floor.
2. In existing elevators, car control buttons with floor designations shall be permitted to be located 54 inches (1370 mm) maximum above the finish floor where a parallel approach is provided.

407.4.6.2 Buttons.
Car control buttons with floor designations shall comply with 407.4.6.2 and shall be raised or flush.

EXCEPTION In existing elevators, buttons shall be permitted to be recessed.

407.4.6.2.1 Size.
Buttons shall be 3/4 inch (19 mm) minimum in their smallest dimension.

407.4.6.2.2 Arrangement.
Buttons shall be arranged with numbers in ascending order. When two or more columns of buttons are provided they shall read from left to right.

407.4.6.3 Keypads.
Car control keypads shall be in a standard telephone keypad arrangement and shall comply with 407.4.7.2.

407.4.6.4 Emergency Controls.
Emergency controls shall comply with 407.4.6.4.

407.4.6.4.1 Height.
Emergency control buttons shall have their centerlines 35 inches (890 mm) minimum above the finish floor.

407.4.6.4.2 Location.
Emergency controls, including the emergency alarm, shall be grouped at the bottom of the panel.

407.4.7 Designations and Indicators of Car Controls.
Designations and indicators of car controls shall comply with 407.4.7.

EXCEPTION In existing elevators, where a new car operating panel complying with 407.4.7 is provided, existing car operating panels shall not be required to comply with 407.4.7.

407.4.7.1 Buttons.
Car control buttons shall comply with 407.4.7.1.

407.4.7.1.1 Type.
Control buttons shall be identified by tactile characters complying with 703.2.

407.4.7.1.2 Location.
Raised characters and tactile designations shall be placed immediately to the left of the control button with which the designations apply.

EXCEPTION Where space on an existing car operating panel precludes tactile markings to the left of the controls, markings shall be placed as near to the control as possible.

407.4.7.1.3 Symbols.
The control buttons for the emergency stop, alarm, door open, door close, main entry floor, and phone, shall be identified with tactile symbols as shown in Table 407.4.7.1.3.

Control Button	Tactile Symbol	Braille Message
EMERGENCY STOP		STOP Three Cells
ALARM		ALARM Four Cells
DOOR OPEN		OPEN Three Cells
DOOR CLOSE		CLOSE Five Cells
MAIN ENTRY FLOOR		VAN Three Cells
PHONE		PHONE Four Cells

TABLE 407.4.7.1.3
ELEVATOR CONTROL BUTTON IDENTIFICATION

407.4.7.1.4 Visible Indicators.
Buttons with floor designations shall be provided with visible indicators to show that a call has been registered. The visible indicator shall extinguish when the car arrives at the designated floor.

407.4.7.2 Keypads.
Keypads shall be identified by characters complying with 703.5 and shall be centered on the corresponding keypad button. The number five key shall have a single raised dot. The dot shall be 0.118 inch (3 mm) to 0.120 inch (3.05 mm) base diameter and 1/8 inch (3.18 mm) high.

407.4.8 Car Position Indicators.
Audible and visible car position indicators shall be provided in elevator cars.

407.4.8.1 Visible Indicators.
Visible indicators shall comply with 407.4.8.1.

407.4.8.1.1 Size.
Characters shall be 1/2 inch (13 mm) high minimum.

407.4.8.1.2 Location.
Indicators shall be located above the car control panel or above the door.

407.4.8.1.3 Floor Arrival.
As the car passes a floor and when a car stops at a floor served by the elevator, the elevator, the corresponding character shall illuminate.

EXCEPTION Destination-oriented elevators shall not be required to comply with 407.4.8.1.3 provided that the visible indicators extinguish when the call answered.

407.4.8.1.4 Destination Indicators.
In destination-oriented elevators, a display shall be provided in the car with visible indicators to show car destinations.

407.4.8.2 Audible Indicators.
Audible indicators shall comply with 407.4.8.2.

407.4.8.2.1 Signal Type.
The signal shall be an automatic verbal annunciator which announces the floor at which the car is about to stop.

EXCEPTION For elevators other than destination-oriented elevators that have a rated speed of 200 feet per minute (1 m/s) or less, a non-verbal audible signal with a frequency of 1500 Hz maximum which sounds as the car passes or is about to stop at a floor served by the elevator shall be permitted.

407.4.8.2.2 Signal Level.
The verbal annunciator shall be 10 dB minimum above ambient, but shall not exceed 80 dB, measured at the annunciator.

407.4.8.2.3 Frequency.
The verbal annunciator shall have a frequency of 300 Hz minimum to 3000 Hz maximum.

407.4.9 Emergency Communication.
Emergency two-way communication systems shall comply with 308. Tactile symbols and characters shall be provided adjacent to the device and shall comply with 703.2.

410 PLATFORM LIFTS

410.1 General.
Platform lifts shall comply with ASME A18.1 (1999 edition or 2003 edition) (incorporated by reference, see "Referenced Standards" in Chapter 1). Platform lifts shall not be attendant-operated and shall provide unassisted entry and exit from the lift.

410.2 Floor Surfaces.
Clear floor space in platform lifts shall comply with 302 and 303.

410.3 Clear Floor Space.
Clear floor space in platform lifts shall comply with 305.

410.4 Platform to Runway Clearance.
The clearance between the platform sill and the edge of any runway landing shall be 1 inch (25 mm) maximum.

410.5 Operable Parts.
Controls for platform lifts shall comply with 309.

410.6 Doors and Gates.
Platform lifts shall have low-energy power-operated doors or gates complying with 404.3. Doors shall remain open for 20 seconds minimum. End doors and gates shall provide a clear width 32 inches (815 mm) minimum. Side doors and gates shall provide a clear width 42 inches (1065 mm) minimum.

EXCEPTION Platform lifts serving two landings maximum and having doors or gates on opposite sides shall be permitted to have self-closing manual doors or gates.

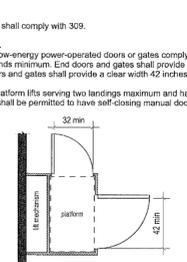


FIGURE 410.6
PLATFORM LIFT DOORS AND GATES

502 PARKING SPACES

502.1 General.
Car and van parking spaces shall comply with 502. Where parking spaces are marked with lines, width measurements of parking spaces and access aisles shall be made from the centerline of the markings.

EXCEPTION Where parking spaces or access aisles are not adjacent to another parking space or access aisle, measurements shall be permitted to include the full width of the line defining the parking space or access aisle.

502.2 Vehicle Spaces.
Each parking space must be at least 12 feet (3658 mm) wide, shall be marked to define the width, and shall have an adjacent access aisle complying with 502.3. See section 406.5 curb ramp location.

EXCEPTION For on-street parallel parking spaces and theme parks or an entertainment complex in which are provided continuous attendant services or designated lots for parking by persons who have disabilities: car parking spaces shall be permitted to be 96 inches (2440 mm) wide minimum, van parking spaces shall be permitted to be 96 inches (2440 mm) wide minimum where the access aisle is 96 inches (2440 mm) wide minimum and shall be designated "van accessible"; alternatively, van parking spaces shall be permitted to be 132 inches (3350 mm) wide minimum where the access aisle is 60 inches (1525 mm) wide minimum and shall be designated "van accessible".

Advisory 502.2 Vehicle Spaces.
Pursuant to a 553.012, F.S., Florida requirements, except a 553.041 (c) parking space and access aisle width, may be waived down to the requirements of the ADA Standards for Accessible Design. No waivers are required for on-street parallel parking spaces and theme parks or an entertainment complex in which are provided continuous attendant services or designated lots for parking by persons who have disabilities pursuant to s.553.041(1)(c), and (d), F.S., and the Exception to 502.2.

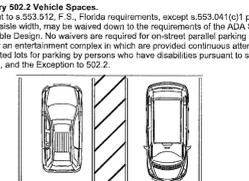


FIGURE 502.2
VEHICLE PARKING SPACES

502.2.1 On-street parallel parking.
Spaces must comply with sections 208 and 502 of the ADA Standards for Accessible Design. Curb curbs adjacent to such spaces must be of a height that does not interfere with the opening and closing of motor vehicle doors.

502.3 Access Aisle.
Access aisles serving parking spaces shall comply with 502.3. Access aisles shall adjoin an accessible route. Two parking spaces shall be permitted to share a common access aisle.

Parking access aisles must be part of an accessible route to the building or facility entrance. Access aisles must be placed adjacent to accessible parking spaces. All spaces must be located on the accessible route that is at least 44 inches (1118 mm) wide so that users are not compelled to walk or wheel behind parked vehicles except behind his or her own vehicle.

EXCEPTION Access aisles are not required for on-street parallel parking.

Advisory 502.3 Access Aisle.
Accessible routes must connect parking spaces to accessible entrances. In parking facilities where the accessible route must cross vehicular traffic lanes, marked crossings enhance pedestrian safety, particularly for people using wheelchairs and other mobility aids. Florida law, s.553.041(1)(a), F.S., requires placement of such crossings such that persons with disabilities are not compelled to walk or wheel behind parked vehicles other than their own vehicle. Florida law, s.553.041(1)(a), F.S., allows on-street accessible parking to not have an access aisle.



FIGURE 502.3
PARKING SPACE ACCESS AISLE

502.3.1 Width.
Access aisles serving car and van parking spaces shall be 60 inches (1525 mm) wide minimum.

502.3.2 Length.
Access aisles shall extend the full length of the parking spaces they serve.

502.3.3 Marking.
Access aisles shall be marked so as to discourage parking in them.

Advisory 502.3.3 Marking.
The method and color of marking are not specified by these requirements but may be addressed by State or local laws or regulations. Because these requirements permit the use of access aisle to be as wide as a parking space, it is important that the aisle be clearly marked.

502.3.4 Location.
Access aisles shall not overlap the vehicular way. Access aisles shall be permitted to be placed on either side of the parking space except for angled van parking spaces which shall have access aisles located on the passenger side of the parking space.

Advisory 502.3.4 Location.
Wheelchair lifts typically are installed on the passenger side of vans. Many drivers, especially those who operate vans, find it more difficult to back into parking spaces than to back out into comparatively unobstructed vehicular lanes. For this reason, where a van and car share an access aisle, consider locating the van access aisle on the passenger side of the van space.

502.4 Floor or Ground Surfaces.
Parking spaces and access aisles serving them shall comply with 302. Access aisles shall be at the same level as the parking spaces they serve. Changes in level are not permitted.

EXCEPTION Slopes not steeper than 1:48 shall be permitted.

Advisory 502.4 Floor or Ground Surfaces.
Access aisles are required to be nearly level in all directions to provide a surface for wheelchair transfer to and from mobility devices. The exception allows sufficient slope for drainage. Built-up curb ramps are not permitted to project into access aisles and parking spaces because they would create slopes greater than 1:48.

502.5 Vertical Clearance.

Parking spaces for vans and access aisles and vehicular routes serving them shall provide a vertical clearance of 98 inches (2490 mm) minimum.

Every nonresidential structure built on or after January 1, 1991, which is designed to use covered or underground parking as the primary available parking space shall design the covered or underground parking facility to maintain a minimum height for the portion of the site-accessible level of the parking facility directly over van-accessible parking spaces and for providing ingress and egress to such parking spaces of at least 9 feet 2 inches (2490 mm). Signs shall be posted to warn operators of handicapped-equipped vans that they cannot pass beyond a certain point due to height limitations. If compliance with this minimum height clearance requirement will cause the structure to exceed local height limitations imposed by local zoning, planning, or fire ordinances, or will result in the imposition of any additional requirements of such ordinances, the structure may exceed the height limitation specified in those particular codes as necessary to comply with the requirements of this section and is exempt from such additional requirements. Structures for which the plans were sealed by an architect prior to January 1, 1991, are exempt from this section.

Advisory 502.5 Vertical Clearance.
Signs provided at entrances to parking facilities informing drivers of clearances and the location of van accessible parking spaces can provide useful customer assistance. Florida law, s.553.511, F.S., requires signs be posted that will warn handicapped-equipped van operators of height limitations so they will not pass beyond a point where the van cannot be maneuvered.

Florida law also preempts local government height restriction ordinances that would prohibit compliance with the minimum height requirements of this section. Also, any local or state law or regulation that prohibits a covered entry from complying with requirements of the ADA may render such jurisdiction in violation of the ADA.

502.6 Identification.
Parking space identification signs shall include the International Symbol of Accessibility complying with 703.7.2.1. Signs identifying van parking spaces when required by 502.2 shall contain the designation "van accessible".

502.6.1
Each such parking space must be stippled in a manner that is consistent with the standards of the controlling jurisdiction for other spaces and prominently outlined with blue paint, and must be repainted when necessary, to be clearly distinguishable as a parking space designated for persons who have disabilities. The space must be posted with a permanent above-grade sign of a color and design approved by the Department of Transportation, which is placed on or at least 60 inches (1525 mm) above the finished floor or ground surface measured to the bottom of the sign and which bears the international symbol of accessibility and the caption "PARKING BY DISABLED PERMIT ONLY." Such a sign, erected after October 1, 1998, must indicate the penalty for illegal use of the space. Any provision of this section to the contrary notwithstanding, in a theme park or an entertainment complex as defined in Section 505.013 in which accessible parking is located in designated lots or areas, the signage indicated in the lot as reserved for accessible parking may be limited at the entrance to the lot in lieu of a sign at each parking place.

Advisory 502.6 Identification.
The required "van accessible" designation is intended to be informative, not restrictive, in identifying those spaces that are better suited for van use. Enforcement of motor vehicle laws, including parking privileges, is a local matter.

Parking spaces and access aisle configurations required for all accessible parking by Florida law, s.553.5041, F.S., meet the van accessible space requirements of the ADA Standards for Accessible Design. Therefore, no accessible space is more suitable than any other accessible space for "van accessible" parking. Florida law only requires "van accessible" parking signs in parking structures where van parking may be limited to the first level accessible spaces.

Florida accessible parking signs must include indication of the priority for legal parking in addition to the accessible parking symbol required by the ADA Standards for Accessible Design.

502.7 Relationship to Accessible Routes.
Parking spaces and access aisles shall be designed so that cars and vans, when parked, cannot obstruct the required clear width of adjacent accessible routes.

Advisory 502.7 Relationship to Accessible Routes.
Wheel stops are an effective way to prevent vehicle overhangs from reducing the clear width of accessible routes.

503 PASSENGER LOADING ZONES

503.1 General.
Passenger loading zones shall comply with 503.

503.2 Vehicle Pull-Up Space.
Passenger loading zones shall provide a vehicular pull-up space 96 inches (2440 mm) wide minimum and 20 feet (6100 mm) long minimum.

503.3 Access Aisle.
Passenger loading zones shall provide access aisles complying with 503 adjacent to the vehicle pull-up space. Access aisles shall adjoin an accessible route and shall not overlap the vehicle way.

503.3.1 Width.
Access aisles serving vehicle pull-up spaces shall be 60 inches (1525 mm) wide minimum.

503.3.2 Length.
Access aisles shall extend the full length of the vehicle pull-up space; they serve.

503.3.3 Marking.
Access aisles shall be marked so as to discourage parking in them.

503.4 Floor and Ground Surfaces.
Access aisles serving them shall comply with 302. Access aisles shall be at the same level as the vehicle pull-up space they serve. Changes in level are not permitted.

EXCEPTION Slopes not steeper than 1:48 shall be permitted.

503.5 Vertical Clearance.
Vehicular pull-up spaces, access aisles serving them, and a vehicular route from an entrance to the passenger loading zone, and from the passenger loading zone to a vehicular exit shall provide a vertical clearance of 114 inches (2895 mm) minimum.

504 STAIRWAYS

504.1 General.
Stairs shall comply with 504.

504.2 Treads and Risers.
All steps on a flight of stairs shall have uniform riser heights and uniform tread depths. Risers shall be 4 inches (102 mm) high minimum and 7 inches (180 mm) high maximum. Treads shall be 11 inches (280 mm) deep minimum.

504.3 Open Risers.
Open risers are not permitted.

504.4 Tread Surface.
Stair treads shall comply with 302. Changes in level are not permitted.

EXCEPTION Treads shall be permitted to have a slope not steeper than 1:48.

Advisory 504.4 Tread Surface.
Consider providing visual contrast on tread nosings, or at the leading edges of treads without nosings, so that stair treads are more visible for people with low vision.

504.5 Nosings.
The radius of curvature at the leading edge of the tread shall be 1/2 inch (13 mm) maximum. Nosings that project beyond risers shall have the underside of the leading edge curved or beveled. Risers shall be permitted to slope under the tread at an angle of 30 degrees maximum vertical. The permitted projection of the nosing shall extend 1 1/4 inches (38 mm) maximum over the tread below.

504.6 Handrail.
Stairs shall have handrails complying with 505.

504.7 Wet Conditions.
Stair treads and landings subject to wet conditions shall be designed to prevent the accumulation of water.

505 HANDRAILS

505.1 General.
Handrails provided along walking surfaces complying with 403, required at ramps complying with 405, and required at stairs complying with 504 shall comply with 505.

Advisory 505.1 General.
Handrails are required on ramp runs with a rise greater than 6 inches (150 mm) (see 405.8) and on ramps with slopes less than 1:20. Handrails are not required on walking surfaces with running slopes less than 1:20. However, handrails are required to comply with 505 when they are provided on walking surfaces with running slopes less than 1:20 (see 403.6). Sections 505.2, 505.3, and 505.10 do not apply to handrails provided on walking surfaces with running slopes less than 1:20 as these sections only reference requirements for ramps and stairs.

505.2 Where Required.
Handrails shall be provided on both sides of stairs and ramps.

EXCEPTION In assembly areas, handrails shall not be required on both sides of aisle ramps with a handrail provided on either side or within the aisle width.

505.3 Continuity.
Handrails shall be continuous within the full length of each stair flight or ramp run. Inside handrails on switchback or dogleg stairs and ramps shall be continuous between flights or runs.

EXCEPTION In assembly areas, handrails on ramps shall not be required to be continuous in aisles serving seating.

505.4 Height.
Top of gripping surfaces of handrails shall be 34 inches (865 mm) minimum and 38 inches (965 mm) maximum vertically above walking surfaces, stair nosings, and ramp surfaces. Handrails shall be at a consistent height above walking surfaces, stair nosings, and ramp surfaces.

Advisory 505.4 Height.
The requirements for stair and ramp handrails in this code are for adults. When children are the principal users in a building or facility (e.g., elementary schools), a second set of handrails at an appropriate height can assist them and aid in preventing accidents. A maximum height of 28 inches (710 mm) measured to the top of the gripping surface from the ramp surface or stair nosing is recommended for children (designed for children). Sufficient vertical clearance between upper and lower handrails 9 inches (230 mm) minimum, should be provided to help prevent entrapment.

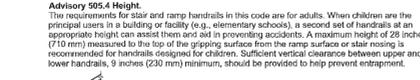


FIGURE 505.4
HANDRAIL HEIGHT

505.5 Clearance.
Clearance between handrail gripping surfaces and adjacent surfaces shall be 1 1/2 inches (38 mm) minimum.

505.6 Gripping Surface.
Handrail gripping surfaces shall be continuous along their length and shall not be obstructed along their tops or sides. The bottoms of handrail gripping surfaces shall not be obstructed for more than 20 percent of their length. Where provided, horizontal projections shall occur 1 1/2 inches (38 mm) minimum below the bottom of the handrail gripping surface.

EXCEPTIONS:
1. Where handrails are provided along walking surfaces with slopes not steeper than 1:20, the bottoms of handrail gripping surfaces shall be permitted to be obstructed along their entire length where they are integral to crash rails or bumper guards.
2. The clearance between horizontal projections and the bottom of the gripping surface shall be permitted to be reduced by 1/8 inch (3.2 mm) for each 1/2 inch (13 mm) of additional half perimeter dimension that exceeds 4 inches (100 mm).

Advisory 505.6 Gripping Surface.
People with disabilities, older people, and others benefit from continuous gripping surfaces that permit users to reach the fingers outward or downward to grasp the handrail, particularly as the user becomes a loss of equilibrium or begins to fall.

505.7 Circular Cross Section.
Handrail gripping surfaces with a circular cross section shall have an outside diameter of 1 1/4 inches (32 mm) minimum and 2 inches (51 mm) maximum.

505.7.2 Non-Circular Cross Sections.
Handrail gripping surfaces with a non-circular cross section shall have a perimeter dimension of 4 inches (100 mm) minimum and 6 1/4 inches (160 mm) maximum, and a cross-section dimension of 2 1/4 inches (57 mm) maximum.



FIGURE 505.7
HORIZONTAL PROJECTIONS BELOW GRIPPING SURFACE

505.7.1 Circular Cross Section.
Handrail gripping surfaces with a circular cross section shall have an outside diameter of 1 1/4 inches (32 mm) minimum and 2 inches (51 mm) maximum.

505.7.2 Non-Circular Cross Sections.
Handrail gripping surfaces with a non-circular cross section shall have a perimeter dimension of 4 inches (100 mm) minimum and 6 1/4 inches (160 mm) maximum, and a cross-section dimension of 2 1/4 inches (57 mm) maximum.

505.8 Surfaces.
Handrail gripping surfaces and any surfaces adjacent to them shall be free of sharp or abrasive elements and shall have rounded edges.

505.9 Fittings.
Handrails shall not rotate within their fittings.

505.10 Handrail Extension.
Handrail gripping surfaces shall extend beyond and in the same direction of stair flights and ramp runs in accordance with 505.10.

EXCEPTIONS:
1. Extensions shall not be required for continuous handrails at the inside turn of switchback or dogleg stairs and ramps.
2. In assembly areas, extensions shall not be required for ramp handrails in aisles serving seating where the handrails are discontinuous to provide access to seating and to permit crossovers within aisles.
3. In alterations, full extensions of handrails shall not be required where such extensions would be hazardous due to plan configuration.

505.10.1 Top and Bottom Extension at Ramps.
A single full-length mirror can accommodate a greater number of people, including children, order for mirrors to be usable by people who are ambulatory and people who use wheelchairs. The top edge of mirrors should be 74 inches (1880 mm) minimum from the floor or ground.

505.10.2 Top Extension at Stairs.
At the top of a stair flight, handrails shall extend horizontally above the landing for 12 inches (305 mm) minimum beyond the top and bottom of ramp runs. Extensions shall return to a wall, guard, or the landing surface, or shall be continuous to the handrail of an adjacent ramp run.

505.10.3 Bottom Extension at Stairs.
At the bottom of a stair flight, handrails shall extend at the slope of the stair flight for a horizontal distance at least equal to the depth beyond the last tread rising. Extension shall return to a wall, guard, or the landing surface, or shall be continuous to the handrail of an adjacent stair flight.

505.10.4 Spout Location.
The spout shall be located 15 inches (380 mm) minimum from the vertical support and 5 inches (125 mm) maximum from the front edge of the unit, including bumpers.

505.10.5 Water Flow.
The purpose of requiring the drinking fountain spout to produce a flow of water 4 inches (100 mm) high minimum is so that a cup can be inserted under the flow of water to provide a drink of water for an individual who, because of a disability, would otherwise be incapable of using the drinking fountain.

505.10.6 Drinking Fountains for Standing Persons.
Spout outlets of drinking fountains for standing persons shall be 38 inches (965 mm) minimum and 43 inches (1090 mm) maximum above the finish floor.

505.10.7 Drinking Fountains for Seated Persons.
Spout outlets of drinking fountains for seated persons shall be

604 WATER CLOSETS AND TOILET COMPARTMENTS

604.1 General.
Water closets and toilet compartments shall comply with 604.2 through 604.8.

EXCEPTION: Water closets and toilet compartments for children's use shall be permitted to comply with 604.9.

604.2 Location.
The water closet shall be positioned with a wall or partition to the rear and to one side. The centerline of the water closet shall be 18 inches (457 mm) minimum to 19 inches (483 mm) maximum from the side wall or partition, except that the water closet shall be 17 inches (430 mm) minimum and 19 inches (483 mm) maximum from the side wall or partition in the ambulatory accessible toilet compartment specified in 604.8.2. Water closets shall be arranged for a left-hand or right-hand approach.

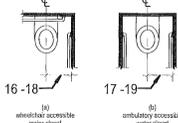


FIGURE 604.2 WATER CLOSET LOCATION

604.3 Clearance.
Clearances around water closets and in toilet compartments shall comply with 604.3.

604.3.1 Size.
Clearance around a water closet shall be 60 inches (1525 mm) minimum measured perpendicular from the side wall and 59 inches (1493 mm) minimum measured perpendicular from the rear wall.


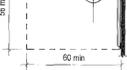


FIGURE 604.3.1 SIZE OF CLEARANCE AT WATER CLOSETS

604.3.2 Overlap.
The required clearance around the water closet shall be permitted to overlap the water closet, associated grab bars, dispensers, sanitary napkin disposal units, coat hooks, shelves, accessible routes, clear floor space and clearances required at other fixtures, and the turning space. No other fixtures or obstructions shall be located within the required water closet clearance.

EXCEPTION: In residential dwelling units, a lavatory complying with 608 shall be permitted on the rear wall 18 inches (457 mm) minimum from the water closet centerline where the clearance at the water closet is 66 inches (1676 mm) minimum measured perpendicular from the rear wall.

Advisory 604.3.2 Overlap.
When the door to the toilet room is placed directly in front of the water closet, the water closet cannot overlap the required maneuvering clearance at the door inside the room.

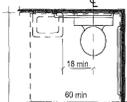

604.4 Seats.
The seat height of a water closet above the finish floor shall be 17 inches (430 mm) minimum and 19 inches (483 mm) maximum measured to the top of the seat. Seats shall not be sprung to return to a lifted position.

EXCEPTIONS:
1. A water closet in a toilet room for a single occupant accessed only through a private (and not for common use or public use) shall not be required to comply with 604.4.
2. In residential dwelling units, the height of water closets shall be permitted to be 15 inches (380 mm) minimum and 19 inches (483 mm) maximum above the finish floor measured to the top of the seat.

604.5 Grab Bars.
Grab bars for water closets shall comply with 609. Grab bars shall be provided on the side wall closest to the water closet and on the rear wall.

EXCEPTIONS:
1. Grab bars shall not be required to be installed in a toilet room for a single occupant accessed only through a private office and not for common use or public use provided that reinforcement has been installed in walls and located so as to permit the installation of bars complying with 604.5.
2. In residential dwelling units, grab bars shall not be required to be installed in toilet or bathroom provided that reinforcement has been installed in walls and located so as to permit the installation of grab bars complying with 604.5.
3. In detention or correction facilities, grab bars shall not be required to be installed in housing or holding cells that are specially designed without protrusions for purposes of suicide prevention.

Advisory 604.5 Grab Bars Exception 2.
Reinforcement must be sufficient to permit the installation of rear and side wall grab bars fully meet all accessibility requirements, including, but not limited to, required length, install height, and structural strength.

604.5.1 Side Wall.
The side wall grab bar shall be 42 inches (1065 mm) long minimum, located 12 inches (305 mm) maximum from the rear wall and extending 54 inches (1370 mm) minimum from the rear wall.

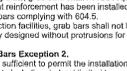


FIGURE 604.5.1 SIDE WALL GRAB BAR AT WATER CLOSETS

604.5.2 Rear Wall.
The rear wall grab bar shall be 36 inches (915 mm) long minimum and extend from the centerline of the water closet 12 inches (305 mm) minimum on one side and 24 inches (610 mm) minimum on the other side.

EXCEPTIONS:
1. The rear grab bar shall be permitted to be 36 inches (915 mm) long minimum, centered on the water closet, where wall space does not permit a length of 36 inches (915 mm) minimum to the location of a recessed fixture adjacent to the water closet.
2. Where an administrative authority requires flush controls for flush valves to be located in position that conflicts with the location of the rear grab bar, then the rear grab bar shall be permitted to be split or shifted to the open side of the toilet area.



FIGURE 604.5.2 REAR WALL GRAB BAR WATER CLOSETS

604.6 Flush Controls.
Flush controls shall be hand operated or automatic. Hand operated flush controls shall comply with 309. Flush controls shall be located on the open side of the water closet except in ambulatory accessible compartments complying with 604.8.2.

Advisory 604.6 Flush Controls.
If plumbing valves are located directly behind the toilet seat, flush valves and related plumbing cause injury or imbalance when a person leans back against them. To prevent causing injury or imbalance, the plumbing can be located behind walls or to the side of the toilet approved by the local authority having jurisdiction, provides a toilet seat lid.

604.7 Dispensers.
Toilet paper dispensers shall comply with 309.4 and shall be 7 inches (180 mm) minimum and 9 inches (230 mm) maximum in front of the water closet measured to the centerline of the dispenser. The outlet of the dispenser shall be 15 inches (380 mm) minimum and 48 inches (1220 mm) maximum above the finish floor and shall not be located behind grab bars. Dispensers shall not be of a type that controls delivery or that does not allow continuous paper flow.

Advisory 604.7 Dispensers.
If toilet paper dispensers are installed above the side wall grab bar, the outlet of the toilet paper dispenser must be 48 inches (1220 mm) maximum above the finish floor and the top of the gripping surface of the dispenser must be 33 inches (840 mm) minimum and 36 inches (915 mm) maximum above the finish floor.

604.8 Toilet Compartments.
Wheelchair accessible toilet compartments shall meet the requirements of 604.8.1 and 604.8.3. Compartments containing more than one plumbing fixture shall comply with 603. Ambulatory accessible compartments shall comply with 604.8.2 and 604.8.3.

604.8.1 Wheelchair Accessible Compartments.
Wheelchair accessible compartments shall comply with 604.8.1.

604.8.1.1 Size.
Wheelchair accessible compartments shall be 60 inches (1525 mm) wide minimum measured perpendicular to the side wall, and 66 inches (1676 mm) deep minimum for wall hung water closets and 59 inches (1493 mm) deep minimum for floor mounted water closets measured perpendicular to the rear wall. Wheelchair accessible compartments for children's use shall be 60 inches (1525 mm) wide minimum measured perpendicular to the side wall, and 59 inches (1500 mm) deep minimum for wall hung and floor mounted water closets measured perpendicular to the rear wall.

Advisory 604.8.1.1 Size.
The minimum space required in toilet compartments is provided so that a person using a wheelchair can maneuver into position at the water closet. This space cannot be obstructed by baby changing tables or other fixtures or obstructions, except as specified at 604.3.2 (Overlap). If toilet compartments are to be used to house fixtures other than those associated with the water closet, they must be designed to exceed the minimum space requirements. Convenience fixtures such as baby changing tables may also be accessible to people with disabilities as well as to other users. Toilet compartments that are designed to meet, and not exceed, the minimum space requirements may not provide adequate space for maneuvering into position at a baby changing table.

604.8.1.2 Doors.
Toilet compartment doors, including door hardware, shall comply with 404 except that if the approach is to the latch side of the compartment door, clearance between the door side of the compartment and any obstruction shall be 42 inches (1065 mm) minimum. Doors shall be located in the front partition or in the side wall or partition farthest from the water closet. Where located in the front partition, the door opening shall be 4 inches (100 mm) maximum from the side wall or partition farthest from the water closet. Where located in the side wall or partition, the door opening shall be 4 inches (100 mm) maximum from the front partition. The door shall be self-closing. A door pull complying with 404.7 shall be placed on both sides of the door near the latch. Toilet compartment doors shall not swing into the minimum required compartment area.

604.8.1.3 Approach.
Compartments shall be arranged for left-hand or right-hand approach to the water closet.

604.8.1.4 Toe Clearance.
The front partition and at least one side partition shall provide a toe clearance of 9 inches (230 mm) minimum above the finish floor and 6 inches (150 mm) deep minimum beyond the compartment side face of the partition, exclusive of partition space for children's use shall provide a toe clearance of 12 inches (305 mm) minimum above the finish floor.

EXCEPTION: Toe clearance at the front partition is not required in a compartment greater than 52 inches (1321 mm) deep with a wall height of 15 1/2 inches (394 mm) deep minimum measured from the outer face of the urinal rim to the back of the fixture.

604.8.1.5 Grab Bars.
Grab bars shall comply with 609. A side-wall grab bar complying with 604.5.1 shall be provided and shall be located on the wall closest to the water closet. In addition, a rear-wall grab bar complying with 604.5.2 shall be provided.

604.8.1.6 Lavatory.
In new construction, the wheelchair accessible toilet compartment shall contain an accessible lavatory within it, which must be at least 19 inches wide by 17 inches deep, normal size, and wall-mounted. The lavatory shall be mounted so as not to overlap the clear floor space areas required by section 604 for the wheelchair accessible toilet compartment and shall comply with section 609. Such lavatories shall be counted as part of the required fixture count for the building. See also section 213.3.4.

604.8.1.7 Water Closets.
In new construction, the accessible water closet within the wheelchair accessible compartment shall be located in the corner, diagonally to the rear wall.

Advisory 604.8.1.6 Lavatory and 604.8.1.7 Water Closets.
Florida law, section 563.04(5), F.S., stipulates that "...required bathing rooms and toilet rooms in new construction shall be designed and constructed..." with an accessible lavatory in the wheelchair accessible compartment and the water closet located in a corner adjacent to the door. The ADA Standards for Accessible Design and therefore this code require wheelchair accessible compartments in new construction and alterations of existing buildings to have self-closing doors. While the Florida lavatory requirement and water closet placement apply only to new construction, they are desirable for all wheelchair accessible compartments and should be considered where feasible.

604.8.2 Ambulatory Accessible Compartments.
Ambulatory accessible compartments shall comply with 604.8.2.

EXCEPTIONS:
1. A lavatory approach complying with 305 shall be permitted to a kitchen sink, in a space where a cook top or conventional range is not provided, and to wet bars.
2. A lavatory in a toilet room or bathing facility for a single occupant accessed only through a private office and not for common use or public use shall not be required to comply with 603.3.
3. In residential dwelling units, cabinetry shall be permitted under lavatories and kitchen sinks provided that all of the following conditions are met:
a. the cabinetry can be removed without removal or replacement of the fixture;
b. the finish floor extends under the cabinetry; and
c. the walls behind and surrounding the cabinetry are finished.
4. A knee clearance of 24 inches (610 mm) minimum above the finish floor or ground shall be permitted at lavatories and sinks used primarily by children 5 years and younger.
5. A parallel approach complying with 305 shall be permitted to lavatories and sinks used primarily by children 5 years and younger.
6. The tip of the overflow shall not be considered in determining knee and toe clearances.
7. No more than one bowl of a multi-bowl sink shall be required to provide knee and toe clearance complying with 306.

604.8.3 Height.
Lavatories and sinks shall be installed with the front of the higher of the rim or counter surface 34 inches (865 mm) maximum above the finish floor or ground.

EXCEPTIONS:
1. A lavatory in a toilet or bathing facility for a single occupant accessed only through a private office and not for common use or public use shall not be required to comply with 603.3.
2. In residential dwelling unit kitchens, sinks that are adjustable to variable heights, 29 inches (735 mm) minimum and 36 inches (915 mm) maximum, shall be permitted where rough plumbing permits connections of supply and drain pipes for sinks mounted at the height of 29 inches (735 mm).

604.8.4 Faucets.
Controls for faucets shall comply with 309. Hand-operated metering faucets shall remain open for 10 seconds minimum.

604.8.5 Exposed Pipes and Surfaces.
Water supply and drain pipes under lavatories and sinks shall be insulated or otherwise configured to protect against contact. There shall be no strap or abrasive surfaces under lavatories and sinks.

604.8.2 Ambulatory Accessible Compartments.
Ambulatory accessible compartments shall comply with 604.8.2.

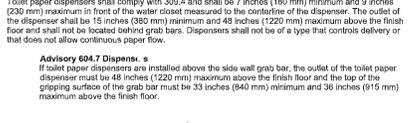


FIGURE 604.8.2 AMBULATORY ACCESSIBLE TOILET COMPARTMENT

604.8.2.1 Size.
Ambulatory accessible compartments shall have a depth of 60 inches (1525 mm) minimum and a width of 35 inches (885 mm) minimum and 37 inches (940 mm) maximum.

604.8.2.2 Doors.
Toilet compartment doors, including door hardware, shall comply with 404, except that if the approach is to the latch side of the compartment door, clearance between the door side of the compartment and any obstruction shall be 42 inches (1065 mm) minimum. The door shall be self-closing. A door pull complying with 404.7 shall be placed on both sides of the door near the latch. Toilet compartment doors shall not swing into the minimum required compartment area.

604.8.2.3 Grab Bars.
Grab bars shall comply with 609. A side-wall grab bar complying with 604.5.1 shall be provided on both sides of the compartment.

604.8.2.4 Coat Hooks and Shelves.
Coat hooks shall be located within one of the reach ranges specified in 308. Shelves shall be located 40 inches (1015 mm) minimum and 48 inches (1220 mm) maximum above the finish floor.

604.9 Water Closets and Toilet Compartments for Children's Use.
Water closets and toilet compartments for children's use shall comply with 604.9.

Advisory 604.9 Water Closets and Toilet Compartments for Children's Use.
The requirements in 604.9 are to be followed where the exception for children's water closets in 604.1 is used. The following table provides additional guidance in applying the specifications for water closets for children according to their age actual seated and reflects the differences in the size, stature, and reach ranges of children ages 3 through 12. The specifications chosen should correspond to the age of the primary user group. The specifications of one age group should be applied consecutively in the installation of a water closet and related elements.

ADVISORY SPECIFICATIONS FOR WATER CLOSETS SERVING CHILDREN AGES 3 THROUGH 12

Water Closet Centerline	Ages 3 and 4	Ages 5 through 8	Ages 9 through 12
12 inches (305 mm)	12 to 15 inches (305 to 380 mm)	15 to 18 inches (380 to 457 mm)	15 to 18 inches (380 to 457 mm)
Toilet Seat Height	11 to 12 inches (280 to 305 mm)	12 to 15 inches (305 to 380 mm)	15 to 17 inches (380 to 430 mm)
Grab Bar Height	18 to 20 inches (450 to 510 mm)	20 to 25 inches (510 to 635 mm)	25 to 27 inches (635 to 685 mm)
Dispenser Height	14 inches (355 mm)	14 to 17 inches (355 to 430 mm)	17 to 19 inches (430 to 483 mm)

604.9.1 Location.
The water closet shall be located with a wall or partition to the rear and to one side. The centerline of the water closet shall be 12 inches (305 mm) minimum and 18 inches (457 mm) maximum from the side wall or partition, except that the water closet shall be 17 inches (430 mm) minimum and 19 inches (483 mm) maximum from the side wall or partition in the ambulatory accessible toilet compartment specified in 604.8.2. Compartments shall be arranged for left-hand or right-hand approach to the water closet.

604.9.2 Clearance.
Clearance around a water closet shall comply with 604.3.

604.9.3 Height.
The height of water closets shall be 11 inches (280 mm) minimum and 17 inches (430 mm) maximum measured to the top of the seat. Seats shall not be sprung to return to a lifted position.

604.9.4 Grab Bars.
Grab bars for water closets shall comply with 604.5.

604.9.5 Flush Controls.
Flush controls shall be hand operated or automatic. Hand operated flush controls shall comply with 309.2 and 309.4 and shall be installed 36 inches (915 mm) maximum above the finish floor. Flush controls shall be located on the open side of the water closet except in ambulatory accessible compartments complying with 604.8.2.

604.9.6 Dispensers.
Toilet paper dispensers shall comply with 309.4 and shall be 7 inches (180 mm) minimum and 9 inches (230 mm) maximum in front of the water closet measured to the centerline of the dispenser. The outlet of the dispenser shall be 14 inches (355 mm) minimum and 19 inches (483 mm) maximum above the finish floor. There shall be a clearance of 1 1/2 inches (38 mm) minimum below the grab bar. Dispensers shall not be of a type that controls delivery or that does not allow continuous paper flow.

604.9.7 Toilet Compartments.
605 URINALS shall comply with 604.8.

605.1 General.
Urinals shall comply with 605. Advisory 605.1 General. Staff-type urinals provide greater accessibility for a broader range of persons, including people of short stature.

605.2 Height and Dep.
Urinals shall be the stall-type or the wall-hung type with the rim 17 inches (430 mm) maximum above the finish floor or ground. Urinals shall be 15 1/2 inches (394 mm) deep minimum measured from the outer face of the urinal rim to the back of the fixture.

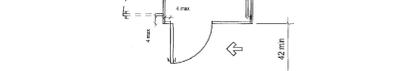


FIGURE 605.2 HEIGHT AND DEPTH OF URINALS

605.3 Clear Floor Space.
A clear floor or ground space complying with 305 positioned for forward approach shall be provided.

605.4 Flush Controls.
Flush controls shall be hand operated or automatic. Hand operated flush controls shall comply with 309.

606 LAVATORIES AND SINKS

606.1 General.
Lavatories and sinks shall comply with 606. Advisory 606.1 General. If soap and towel dispensers are provided, they must be located within the reach ranges specified in 308. Locate soap and towel dispensers so that they are conveniently usable by a person at the accessible lavatory.

606.2 Clear Floor Space.
A clear floor space complying with 305, positioned for a forward approach, and knee and toe clearance complying with 306 shall be provided.

EXCEPTIONS:
1. A lavatory approach complying with 305 shall be permitted to a kitchen sink, in a space where a cook top or conventional range is not provided, and to wet bars.
2. A lavatory in a toilet room or bathing facility for a single occupant accessed only through a private office and not for common use or public use shall not be required to comply with 603.3.
3. In residential dwelling units, cabinetry shall be permitted under lavatories and kitchen sinks provided that all of the following conditions are met:
a. the cabinetry can be removed without removal or replacement of the fixture;
b. the finish floor extends under the cabinetry; and
c. the walls behind and surrounding the cabinetry are finished.
4. A knee clearance of 24 inches (610 mm) minimum above the finish floor or ground shall be permitted at lavatories and sinks used primarily by children 5 years and younger.
5. A parallel approach complying with 305 shall be permitted to lavatories and sinks used primarily by children 5 years and younger.
6. The tip of the overflow shall not be considered in determining knee and toe clearances.
7. No more than one bowl of a multi-bowl sink shall be required to provide knee and toe clearance complying with 306.

606.3 Height.
Lavatories and sinks shall be installed with the front of the higher of the rim or counter surface 34 inches (865 mm) maximum above the finish floor or ground.

EXCEPTIONS:
1. A lavatory in a toilet or bathing facility for a single occupant accessed only through a private office and not for common use or public use shall not be required to comply with 603.3.
2. In residential dwelling unit kitchens, sinks that are adjustable to variable heights, 29 inches (735 mm) minimum and 36 inches (915 mm) maximum, shall be permitted where rough plumbing permits connections of supply and drain pipes for sinks mounted at the height of 29 inches (735 mm).

606.4 Faucets.
Controls for faucets shall comply with 309. Hand-operated metering faucets shall remain open for 10 seconds minimum.

606.5 Exposed Pipes and Surfaces.
Water supply and drain pipes under lavatories and sinks shall be insulated or otherwise configured to protect against contact. There shall be no strap or abrasive surfaces under lavatories and sinks.

607 BATH TUBS

607.1 General.
Bathrooms shall comply with 607.

607.2 Clearance.
Clearance in front of bathtubs shall extend the length of the bathtub and shall be 30 inches (760 mm) wide minimum. A lavatory complying with 606 shall be permitted at the control end of the clearance. Where a permanent seat is provided at the head end of the bathtub, the clearance shall extend 12 inches (305 mm) minimum beyond the wall at the head end of the bathtub.



FIGURE 607.2 CLEARANCE FOR BATH TUBS

607.3 Seat.
A permanent seat at the head end of the bathtub or a removable-in-tub seat shall be provided. Seats shall comply with 610.

607.4 Grab Bars.
Grab bars for bathtubs shall comply with 609 and shall be provided in accordance with 607.4.1 or 607.4.2.

EXCEPTIONS:
1. Grab bars shall not be required to be installed in a bathtub located in a bathing facility for a single occupant accessed only through a private office and not for common use or public use provided that reinforcement has been installed in walls and located so as to permit the installation of grab bars complying with 607.4.
2. In residential dwelling units, grab bars shall not be required to be installed in bathtubs located in bathing facilities provided that reinforcement has been installed in walls and located so as to permit the installation of grab bars complying with 607.4.
607.4.1 Bathtubs With Permanent Seats.
For bathtubs with permanent seats, grab bars shall be provided in accordance with 607.4.1.

607.4.1 Back Wall.
Two grab bars shall be installed on the back wall, one located in accordance with 609.4 and the other located 9 inches (229 mm) minimum and 10 inches (255 mm) maximum above the rim of the bathtub. Each grab bar shall be installed 15 inches (380 mm) maximum from the head end wall and 12 inches (305 mm) maximum from the control end wall.

607.4.2 Control End Wall.
A grab bar 24 inches (610 mm) long minimum shall be installed on the control end wall at the front edge of the bathtub.

607.4.2 Bathrooms Without Permanent Seats.
For bathtubs without permanent seats, grab bars shall comply with 607.4.2.

607.5 Controls.
Controls, other than drain stoppers, shall be located on an end wall. Controls shall be between the bathtub rim and grab bar, and between the open side of the bathtub and the centerline of the width of the bathtub. Controls shall comply with 309.4.

607.6 Shower Spray Unit and Water.
A shower spray unit with a hose 59 inches (1500 mm) long minimum that can be used both as a fixed-position overhead head and as a hand-held shower shall be provided. The shower spray unit shall have an on/off control with a non-positive shutoff. If an adjustable-height shower head on a vertical bar is used, the bar shall be installed so as not to obstruct the use of grab bars. Bathtub shower spray units shall deliver water that is 120°F (49°C) maximum.

Advisory 607.6 Shower Spray Unit and Water.
A hand-held shower spray unit is capable of delivering water pressure substantially equivalent to fixed shower heads.

607.7 Bathtub Enclosures.
Enclosures for bathtubs shall not obstruct controls, faucets, shower and spray units or obstruct transfer from wheelchairs onto bathtub seats or into bathtubs. Enclosures on bathtubs shall not have tracks installed on the rim of the open face of the bathtub.

608 SHOWER COMPARTMENTS

608.1 General.
Shower compartments shall comply with 608.

Advisory 608.1 General.
bathroom because the shower area provides additional maneuvering space.

608.2 Size and Clearances for Shower Compartments.
Shower compartments shall have size and clearances complying with 608.2.

608.2.1 Transfer Type Shower Compartments.
Transfer type shower compartments shall be 36 inches (915 mm) by 36 inches (915 mm) clear inside dimensions measured at the center points of opposing sides and shall have a 36 inch (915 mm) wide minimum entry on the base of the shower compartment. Clearance of 36 inches (915 mm) wide minimum by 48 inches (1220 mm) long minimum measured from the control wall shall be provided.

608.2.2 Transfer Type Shower Compartments.
Transfer type shower compartments shall be 36 inches (915 mm) by 36 inches (915 mm) clear inside dimensions measured at the center points of opposing sides and shall have a 36 inch (915 mm) wide minimum entry on the base of the shower compartment. Clearance of 36 inches (915 mm) wide minimum by 48 inches (1220 mm) long minimum measured from the control wall shall be provided.

608.2.3 Transfer Type Shower Compartments.
Transfer type shower compartments shall be 36 inches (915 mm) by 36 inches (915 mm) clear inside dimensions measured at the center points of opposing sides and shall have a 36 inch (915 mm) wide minimum entry on the base of the shower compartment. Clearance of 36 inches (915 mm) wide minimum by 48 inches (1220 mm) long minimum measured from the control wall shall be provided.

608.2.4 Transfer Type Shower Compartments.
Transfer type shower compartments shall be 36 inches (915 mm) by 36 inches (915 mm) clear inside dimensions measured at the center points of opposing sides and shall have a 36 inch (915 mm) wide minimum entry on the base of the shower compartment. Clearance of 36 inches (915 mm) wide minimum by 48 inches (1220 mm) long minimum measured from the control wall shall be provided.

608.2.5 Transfer Type Shower Compartments.
Transfer type shower compartments shall be 36 inches (915 mm) by 36 inches (915 mm) clear inside dimensions measured at the center points of opposing sides and shall have a 36 inch (915 mm) wide minimum entry on the base of the shower compartment. Clearance of 36 inches (915 mm) wide minimum by 48 inches (1220 mm) long minimum measured from the control wall shall be provided.

608.2.6 Transfer Type Shower Compartments.
Transfer type shower compartments shall be 36 inches (915 mm) by 36 inches (915 mm) clear inside dimensions measured at the center points of opposing sides and shall have a 36 inch (915 mm) wide minimum entry on the base of the shower compartment. Clearance of 36 inches (915 mm) wide minimum by 48 inches (1220 mm) long minimum measured from the control wall shall be provided.

608.2.7 Transfer Type Shower Compartments.
Transfer type shower compartments shall be 36 inches (915 mm) by 36 inches (915 mm) clear inside dimensions measured at the center points of opposing sides and shall have a 36 inch (915 mm) wide minimum entry on the base of the shower compartment. Clearance of 36 inches (915 mm) wide minimum by 48 inches (1220 mm) long minimum measured from the control wall shall be provided.

608.2.8 Transfer Type Shower Compartments.
Transfer type shower compartments shall be 36 inches (915 mm) by 36 inches (915 mm) clear inside dimensions measured at the center points of opposing sides and shall have a 36 inch (915 mm) wide minimum entry on the base of the shower compartment. Clearance of 36 inches (915 mm) wide minimum by 48 inches (1220 mm) long minimum measured from the control wall shall be provided.

608.2.9 Transfer Type Shower Compartments.
Transfer type shower compartments shall be 36 inches (915 mm) by 36 inches (915 mm) clear inside dimensions measured at the center points of opposing sides and shall have a 36 inch (915 mm) wide minimum entry on the base of the shower compartment. Clearance of 36 inches (915 mm) wide minimum by 48 inches (1220 mm) long minimum measured from the control wall shall be provided.

608.2.10 Transfer Type Shower Compartments.
Transfer type shower compartments shall be 36 inches (915 mm) by 36 inches (915 mm) clear inside dimensions measured at the center points of opposing sides and shall have a 36 inch (915 mm) wide minimum entry on the base of the shower compartment. Clearance of 36 inches (915 mm) wide minimum by 48 inches (1220 mm) long minimum measured from the control wall shall be provided.

608.2.11 Transfer

608.5.2 Standard Roll-in Type Shower Compartments.
In standard roll-in type shower compartments, the controls, faucets, and shower spray unit shall be located above the grab bar, but no higher than 48 inches (1220 mm) above the shower floor. Where a seat is provided, the controls, faucets, and shower spray unit shall be installed on the back wall adjacent to the seat wall and shall be located 27 inches (688 mm) maximum from the seat wall.

Advisory 608.5.2 Standard Roll-in Type Shower Compartments.
In standard roll-in type showers without seats, the shower head and operable parts can be located on any of the three walls of the shower without adversely affecting accessibility.

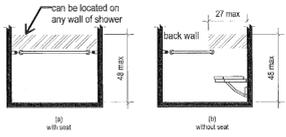


FIGURE 608.5.2 STANDARD ROLL-IN TYPE SHOWER COMPARTMENT CONTROL LOCATION

608.5.3 Alternate Roll-in Type Shower Compartments.
In alternate roll-in type shower compartments, the controls, faucets, and shower spray unit shall be located above the grab bar, but no higher than 48 inches (1220 mm) above the shower floor. Where a seat is provided, the controls, faucets, and shower spray unit shall be located on the side wall adjacent to the seat 27 inches (688 mm) maximum from the side wall behind the seat or shall be located on the back wall opposite the seat 15 inches (380 mm) maximum, left or right, of the centerline of the seat. Where a seat is not provided, the controls, faucets, and shower spray unit shall be installed on the side wall furthest from the compartment entry.

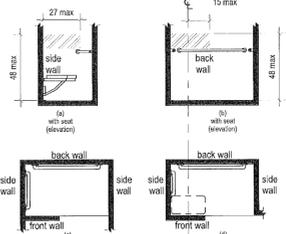


FIGURE 608.5.3 ALTERNATE ROLL-IN TYPE SHOWER COMPARTMENT CONTROL LOCATION

608.6 Shower Spray Unit and Water.
A shower spray unit with a hose 59 inches (1500 mm) long minimum that can be used both as a fixed-position shower head and as a hand-held shower shall be provided. The shower spray unit shall have an on/off control with a non-positive shut-off. If an adjustable-height shower head on a vertical bar is used, the bar shall be installed so as not to obstruct the use of grab bars. Shower spray units shall deliver water that is 100°F (40°C) maximum.

EXCEPTION: A fixed shower head located at 48 inches (1220 mm) maximum above the shower finish floor shall be permitted instead of a hand-held spray unit in facilities that are not medical care facilities, long-term care facilities, transient lodging guest rooms, or residential dwelling units.

Advisory 608.6 Shower Spray Unit and Water.
Ensure that hand-held shower spray units are capable of delivering water pressure substantially equivalent to fixed shower heads.

608.7 Thresholds.
Thresholds in roll-in type shower compartments shall be 1/2 inch (13 mm) high maximum in accordance with 303. In transfer type shower compartments, thresholds 1/2 inch (13 mm) high maximum shall be beveled, rounded, or vertical.

EXCEPTION: A threshold 2 inches (51 mm) high maximum shall be permitted in transfer type shower compartments in existing facilities where provision of a 1/2 inch (13 mm) high threshold would disturb the structural reinforcement of the floor slab.

608.8 Shower Enclosures.
Enclosures for shower compartments shall not obstruct controls, faucets, and shower spray units or obstruct transfer from wheelchairs onto shower seats.

609 GRAB BARS

609.1 General.
Grab bars in toilet facilities and bathing facilities shall comply with 609.

609.2 Cross Section.
Grab bars shall have a cross section complying with 609.2.1 or 609.2.2.

609.2.1 Circular Cross Section.
Grab bars with circular cross sections shall have an outside diameter of 1 1/4 inches (32 mm) minimum and 2 inches (51 mm) maximum.

609.2.2 Non-Circular Cross Section.
Grab bars with non-circular cross sections shall have a cross-section dimension of 2 inches (51 mm) maximum and a perimeter dimension of 4 inches (100 mm) minimum and 4.8 inches (120 mm) maximum.



FIGURE 609.2 GRAB BAR NON-CIRCULAR CROSS SECTION

609.3 Spacing.
The space between the wall and the grab bar shall be 1 1/2 inches (38 mm). The space between the grab bar and projecting objects below and at the ends shall be 1 1/2 inches (38 mm) minimum. The space between the grab bar and projecting objects above shall be 1 1/2 inches (38 mm) minimum.

EXCEPTION: The space between the grab bars and shower controls, shower fittings, and other grab bars above shall be permitted to be 1 1/2 inches (38 mm) minimum.



FIGURE 609.3 SPACING OF GRAB BARS

609.4 Position of Grab Bars.
Grab bars shall be installed in a horizontal position, 33 inches (840 mm) minimum and 36 inches (915 mm) maximum above the finish floor measured to the top of the gripping surface, except that at water closets facilities the use of 304.5, grab bars shall be installed in a horizontal position 19 inches (485 mm) minimum and 27 inches (685 mm) maximum above the finish floor measured to the top of the gripping surface. The height of the lower grab bar on the back wall of a bathtub shall comply with 607.4.1.1 or 607.4.2.1.

609.5 Surface Hazards.
Grab bars and any wall or other surfaces adjacent to grab bars shall be free of sharp or abrasive elements and shall have rounded edges.

609.6 Fittings.
Grab bars shall not rotate within their fittings.

609.7 Installation.
Grab bars shall be installed in any manner that provides a gripping surface at the specified locations and that does not obstruct the required clear floor space.

609.8 Structural Strength.
Allowable stresses shall not be exceeded for materials used when a vertical or horizontal force of 250 pounds (112 N) is applied at any point on the grab bar, fastener, mounting device, or supporting structure.

610 SEATS

610.1 General.
Seats in bathrooms and shower compartments shall comply with 610.

610.2 Bathing Seats.
The top of bathing seats shall be 17 inches (430 mm) minimum and 19 inches (485 mm) maximum above the bathroom finish floor. The depth of a removable in-tub seat shall be 15 inches (380 mm) minimum and 16 inches (405 mm) maximum. The seat shall be capable of secure placement. Permanent seats at the head end of the bathtub shall be 15 inches (380 mm) deep minimum and shall extend from the back wall to or beyond the outer edge of the bathtub.

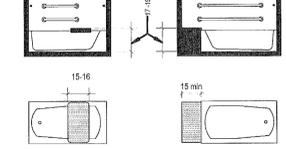


FIGURE 610.2 BATHING SEATS

610.3 Shower Compartment Seats.
Where a seat is provided in a standard roll-in shower compartment, it shall be a folding type, shall be installed on the side wall adjacent to the controls, and shall extend from the back wall to a point within 3 inches (75 mm) of the compartment entry. Where a seat is provided in an alternate roll-in type shower compartment, it shall be a folding type, shall be installed on the front wall opposite the back wall, and shall extend from the adjacent side wall to a point within 3 inches (75 mm) of the compartment entry. In transfer-type showers, the seat shall extend from the back wall to a point within 3 inches (75 mm) of the compartment entry. The top of the seat shall be 17 inches (430 mm) minimum and 19 inches (485 mm) maximum above the bathroom finish floor. Seats shall comply with 610.3.1 or 610.3.2.

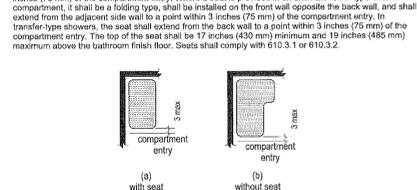


FIGURE 610.3 RECTANGULAR SEATS

610.3.1 Rectangular Seats.
The rear edge of a rectangular seat shall be 2 1/2 inches (64 mm) maximum and the front edge 15 inches (380 mm) minimum and 16 inches (405 mm) maximum from the seat wall. The side edge of the seat shall be 1 1/2 inches (38 mm) maximum from the adjacent wall.

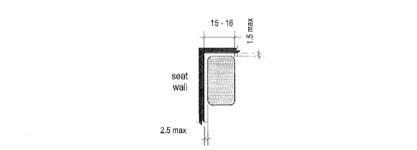


FIGURE 610.3.1 RECTANGULAR SHOWER SEAT

610.3.2 L-Shaped Seats.
The rear edge of an L-shaped seat shall be 2 1/2 inches (64 mm) maximum and the front edge 15 inches (380 mm) minimum and 16 inches (405 mm) maximum from the seat wall. The rear edge of the "L" portion of the seat shall be 1 1/2 inches (38 mm) maximum from the wall and the front edge shall be 14 inches (350 mm) minimum and 13 inches (330 mm) maximum from the wall. The end of the "L" shall be 22 inches (560 mm) minimum and 23 inches (585 mm) maximum from the main seat wall.

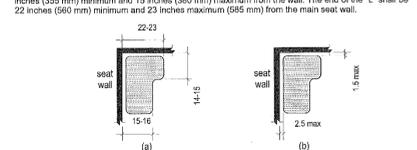


FIGURE 610.3.2 L-SHAPED SHOWER SEAT

610.4 Structural Strength.
Allowable stresses shall not be exceeded for materials used when a vertical or horizontal force of 250 pounds (112 N) is applied at any point on the seat, fastener, mounting device, or supporting structure.

Chapter 7 - Communication Elements and Features

702 FIRE ALARM SYSTEMS

702.1 General.
Fire alarm systems shall have permanently installed audible and visible alarms complying with NFPA 72 (1999 or 2002 edition) (incorporated by reference, see "Referenced Standards" in Chapter 1), except that the maximum allowable sound level of audible notification appliances complying with section 4-3.2.1 of NFPA 72 (1999 edition) shall have a sound level no more than 110 dB at the minimum hearing distance from the audible appliance. In addition, alarms in guest rooms required to provide communication features shall comply with sections 4-3 and 4-4 of NFPA 72 (1999 edition) or sections 7.4 and 7.5 of NFPA 72 (2002 edition).

EXCEPTION: Fire alarm systems in medical care facilities shall be permitted to be provided in accordance with industry practice.

703 SIGNS

703.1 General.
Signs shall comply with 703. Where both visual and tactile characters are required, either one sign with both visual and tactile characters, or two separate signs, one with visual, and one with tactile characters, shall be provided.

703.2 Raised Characters.
Raised characters shall comply with 703.2 and shall be duplicated in braille complying with 703.3. Raised characters shall be installed in accordance with 703.4.

Advisory 703.2 Raised Characters.
Signs that are designed to be read by touch should not have sharp or abrasive edges.

703.2.1 Depth.
Raised characters shall be 1/32 inch (0.8 mm) minimum above their background.

703.2.2 Case.
Characters shall be uppercase.

703.2.3 Style.
Characters shall be sans serif. Characters shall not be italic, oblique, script, highly decorative, or of other unusual forms.

703.2.4 Character Proportion.
Characters shall be selected from fonts where the width of the uppercase letter "O" is 95 percent minimum and 110 percent maximum of the height of the uppercase letter "I".

703.2.5 Character Height.
Character height measured vertically from the baseline of the character shall be 5/8 inch (16 mm) minimum and 2 inches (51 mm) maximum based on the height of the uppercase letter "I".

EXCEPTION: Where separate raised and visual characters with the same information are provided, raised character height shall be permitted to be 1/2 inch (13 mm) minimum.

FIGURE 703.2.5 HEIGHT OF RAISED CHARACTERS

703.2.6 Stroke Thickness.
Stroke thickness of the uppercase letter "I" shall be 15 percent maximum of the height of the character.


703.2.7 Character Spacing.
Character spacing shall be measured between the two closest points of adjacent raised characters within a message, excluding word spaces. Where characters have rectangular cross sections, spacing between individual raised characters shall be 1/8 inch (3.2 mm) minimum and 4 times the raised character stroke width maximum. Where characters have other cross sections, spacing between individual raised characters shall be 1/16 inch (1.6 mm) minimum and 4 times the raised character stroke width maximum at the base of the cross sections, and 1/8 inch (3.2 mm) minimum and 4 times the raised character stroke width maximum at the top of the cross sections. Characters shall be separated from raised borders and decorative elements 3/8 inch (9.5 mm) minimum.

703.2.8 Line Spacing.
Spacing between the baselines of separate lines of characters within a message shall be 135 percent minimum and 170 percent maximum of the raised character height.

703.3 Braille.
Braille shall be contracted (Grade 2) and shall comply with 703.3 and 703.4.

703.3.1 Dimensions and Capitalization.
The Braille side shall have a domed or rounded shape and shall comply with Table 703.3.1. The indication of an uppercase letter or letters shall only be used before the first word of sentences, proper nouns and names, individual letters of the alphabet, initials, and acronyms.

BRAILLE DIMENSIONS		MIN. TO MAX. IN INCHES
Dot base diameter		0.059 (1.5 mm) to 0.063 (1.6 mm)
Distance between two dots in the same cell		0.090 (2.3 mm) to 0.100 (2.5 mm)
Distance between corresponding dots in adjacent cells		0.241 (6.1 mm) to 0.330 (7.6 mm)
Dot height		0.026 (0.6 mm) to 0.037 (0.9 mm)
Distance between corresponding dots from one cell directly below		0.390 (10 mm) to 0.400 (10.2 mm)

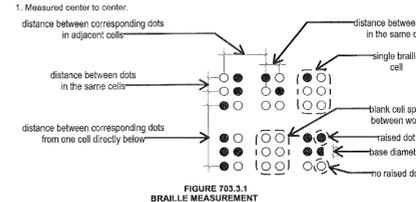

703.3.2 Postive.
Braille shall be positioned below the corresponding text. If text is multi-lined, braille shall be placed below the entire text. Braille shall be separated 3/8 inch (9.5 mm) minimum from other tactile characters and 3/8 inch (9.5 mm) minimum from raised borders and decorative elements.


EXCEPTION: Braille provided on elevator car controls shall be separated 3/16 inch (4.8 mm) minimum and shall be located either directly below or adjacent to the corresponding raised characters or symbols.



703.4 Installation Height and Location.
Signs with tactile characters shall comply with 703.4.

703.4.1 Height Above Finish Floor or Ground.
Tactile characters or signs shall be located 48 inches (1220 mm) minimum above the finish floor or ground surface, measured from the baseline of the highest tactile character.

EXCEPTION: Tactile characters for elevator car controls shall not be required to comply with 703.4.1.

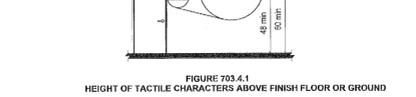

703.4.2 Location.
Where a tactile sign is provided at a door, the sign shall be located alongside the door at the latch side. Where a tactile sign is provided at double doors with one active leaf, the sign shall be located on the inactive leaf. Where a tactile sign is provided at double doors with two active leaves, the sign shall be located to the right of the right hand door. Where there is no wall space at the latch side of a door or at the right side of double doors, signs shall be located on the nearest adjacent wall. Signs containing tactile characters shall be located so that a clear floor space of 18 inches (455 mm) minimum by 18 inches (455 mm) minimum, centered on the tactile characters, is provided beyond the arc of any door swing between the closed position and 45 degree open position.

EXCEPTION: Signs with tactile characters shall be permitted on the push side of doors with closers and without hold-open devices.



703.5 Visual Characters.
Visual characters shall comply with 703.5.

EXCEPTION: Where visual characters comply with 703.2 and are accompanied by braille complying with 703.3, they shall not be required to comply with 703.5.2 through 703.5.9.

703.5.1 Finish and Contrast.
Characters and their background shall have a non-glare finish. Characters shall contrast with their background. Additional factors affecting the ease with which the text can be distinguished from its background include shadows cast by lighting sources, surface glare, and the uniformity of the text and background colors and textures.

Advisory 703.5.1 Finish and Contrast.
Signs are more legible for persons with low vision when characters contrast as much as possible with their background. Additional factors affecting the ease with which the text can be distinguished from its background include shadows cast by lighting sources, surface glare, and the uniformity of the text and background colors and textures.

703.5.2 Case.
Characters shall be uppercase or lowercase or a combination of both.

703.5.3 Style.
Characters shall be conventional in form. Characters shall not be italic, oblique, script, highly decorative, or of other unusual forms.

703.5.4 Character Proportions.
Characters shall be selected from fonts where the width of the uppercase letter "O" is 95 percent minimum and 110 percent maximum of the height of the uppercase letter "I".

703.5.5 Character Height.
Minimum character height shall comply with Table 703.5.5. Viewing distance shall be measured as the horizontal distance between the character and an obstruction preventing further approach towards the sign. Character height shall be based on the uppercase letter "I".

EXCEPTION: Where separate raised and visual characters with the same information are provided, raised character height shall be permitted to be 1/2 inch (13 mm) minimum.

TABLE 703.5.5 VISUAL CHARACTER HEIGHT			
HEIGHT TO FINISH FLOOR OR GROUND FROM BASELINE DISTANCE	HORIZONTAL VIEWING DISTANCE	MINIMUM CHARACTER HEIGHT	
40 inches (1015 mm) to 70 inches (1780 mm)	< 72 inches (1830mm)	5/8 inch (16 mm)	
> 70 inches (1780 mm) to < 120 inches (3050 mm)	72 inches (1830mm) & >	5/8 inch (16 mm) + 1/8 inch (3.2 mm) per foot (305 mm) of viewing distance above 72 inches (1830 mm)	
> 120 inches (3050 mm)	< 21 feet (6400 mm) & >	2 inches (51 mm) + 1/16 inch (2 mm) per foot (305 mm) of viewing distance above 72 inches (1830 mm)	
		3 inches (75 mm)	
		21 feet (6400 mm) & >	3 inches (75 mm) + 1/16 inch (2 mm) per foot (305 mm) of viewing distance above 21 feet (6400 mm)

703.5.6 Height From Finish Floor or Ground.
Visual characters shall be 40 inches (1015 mm) minimum above the finish floor or ground.

EXCEPTION: Visual characters indicating elevator car controls shall not be required to comply with 703.5.6.

703.5.7 Stroke Thickness.
Stroke thickness of the uppercase letter "I" shall be 10 percent minimum and 30 percent maximum of the height of the character.

703.5.8 Character Spacing.
Character spacing shall be measured between the two closest points of adjacent characters, excluding word spaces. Spacing between individual characters shall be 10 percent minimum and 35 percent maximum of character height.

703.5.9 Line Spacing.
Spacing between the baselines of separate lines of characters within a message shall be 135 percent minimum and 170 percent maximum of the character height.

703.6 Pictograms.
Pictograms shall comply with 703.6.

703.6.1 Pictogram Field.
Pictograms shall have a field height of 6 inches (150 mm) minimum. Characters and braille shall not be located in the pictogram field.



703.6.2 Finish and Contrast.
Pictograms and their field shall have a non-glare finish. Pictograms shall contrast with their field with either a light pictogram on a dark field or a dark pictogram on a light field.

Advisory 703.6.2 Finish and Contrast.
Signs are more legible for persons with low vision when characters contrast as much as possible with their background. Additional factors affecting the ease with which the text can be distinguished from its background include shadows cast by lighting sources, surface glare, and the uniformity of the text and background colors and textures.

703.6.3 Text Descriptors.
Pictograms shall have text descriptors located directly below the pictogram field. Text descriptors shall comply with 703.2, 703.3 and 703.4.

703.7 Symbols of Accessibility.
Symbols of accessibility shall comply with 703.7.

703.7.1 Finish and Contrast.
Symbols of accessibility and their background shall have a non-glare finish. Symbols of accessibility shall contrast with their background with either a light symbol on a dark background or a dark symbol on a light background.

Advisory 703.7.1 Finish and Contrast.
Signs are more legible for persons with low vision when characters contrast as much as possible with their background. Additional factors affecting the ease with which the text can be distinguished from its background include shadows cast by lighting sources, surface glare, and the uniformity of the text and background colors and textures.

703.7.2 International Symbol of Access.
The International Symbol of Accessibility shall comply with Figure 703.7.2.1.



703.7.2.2 International Symbol of T.
The International Symbol of TTY shall comply with Figure 703.7.2.2.



703.7.2.3 Volume Control Telephone.
Telephones with a volume control shall be identified by a pictogram of a telephone handset with radiating sound waves on a square field as shown in Figure 703.7.2.3.



703.7.2.4 Assistive Listening System.
Assistive listening systems shall be identified by the International Symbol of Access for Hearing Loss complying with Figure 703.7.2.4.



703.7.2.6 International Symbol of Access for Hearing Loss.
The International Symbol of Access for Hearing Loss shall comply with Figure 703.7.2.6.

BUILDING	REVIEWER	DATE
STRUCTURAL		
MECHANICAL		
ELECTRICAL		
PLUMBING		
SITE CIVIL		

704 TELEPHONES


704.1 General.
Public telephones shall comply with 704.

704.2 Wheelchair Accessible Telephones.
Wheelchair accessible telephones shall comply with 704.2.

704.2.1 Clear Floor or Ground Space.
A clear floor or ground space complying with 305 shall be provided. The clear floor or ground space shall not be obstructed by bases, enclosures, or seats.

Advisory 704.2.1 Clear Floor or Ground Space.
Because clear floor and ground space is required to be unobstructed, telephones, enclosures and related telephone book storage cannot encroach on the required clear floor or ground space and must comply with the provisions for protruding objects. (See Section 307).

704.2.1.1 Parallel Approach.
Where a parallel approach is provided, the distance from the edge of the telephone enclosure to the face of the telephone unit shall be 10 inches (255 mm) maximum.

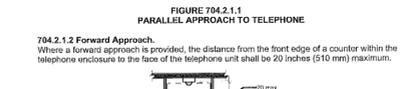

704.2.1.2 Forward Approach to Telephone.
Where a forward approach is provided, the distance from the front edge of a counter within the telephone enclosure to the face of the telephone unit shall be 20 inches (510 mm) maximum.



704.2.2 Operable Parts.
Operable parts shall comply with 309. Telephones shall have push-button controls where such service is available.

704.2.3 Telephone Directory.
Telephone directories, where provided, shall be located in accordance with 309.


704.2.4 Cord Length.
The cord from the telephone to the handset shall be 29 inches (735 mm) long minimum.

704.3 Volume Control Telephones.
Public telephones required to have volume controls shall be equipped with a receive volume control that provides a gain adjustable up to 20 dB minimum. For nonvariable volume control, provide at least one intermediate step of 12 dB of gain minimum. An automatic reset shall be provided.



Advisory 704.3 Volume Control Telephones.
Amplifiers on pay phones are located in the base or the handset or are built into the telephone. Most are operated by pressing a button or key. If the microphone in the handset is not being used, a mute button that temporarily turns off the microphone can also reduce the amount of background noise which the person hears in the earpiece. If a volume adjustment is provided that allows the user to set the level anywhere from the base volume to the upper requirement of 20 dB, there is no need to specify a lower limit. If a stepped volume control is provided, one of the intermediate levels must provide 12 dB of gain. Consider compatibility issues when matching an amplified handset with a phone or phone system. Amplified handsets that can be switched with pay telephone handsets are available. Portable and in-line amplifiers can be used with some phones but are not practical at most public phones covered by these requirements.

IN COMPLIANCE WITH CODE 2014 FBC 211 AND 602.
 211 GENERAL WHERE DRINKING FOUNTAINS ARE PROVIDED ON AN EXTERIOR SITE, ON A FLOOR, OR WITHIN A SECURED AREA THEY SHALL BE PROVIDED IN ACCORDANCE WITH 211.
 EXCEPTION: IN DETENTION OR CORRECTIONAL FACILITIES, DRINKING FOUNTAINS ONLY SERVING HOLDING OR HOUSING CELLS NOT REQUIRED TO COMPLY WITH 211 SHALL NOT BE REQUIRED TO COMPLY WITH 211.
 211.2 MINIMUM NUMBER NO FEWER THAN TWO DRINKING FOUNTAINS SHALL BE PROVIDED. ONE DRINKING FOUNTAIN SHALL COMPLY WITH 602.1 THROUGH 602.6 AND ONE DRINKING FOUNTAIN SHALL COMPLY WITH 602.7.
 EXCEPTION: WHERE A SINGLE DRINKING FOUNTAIN COMPLES WITH 602.1 THROUGH 602.6 AND 602.7, IT SHALL BE PERMITTED TO BE SUBSTITUTED FOR TWO SEPARATE DRINKING FOUNTAINS.
 211.3 MORE THAN MINIMUM NUMBER WHERE MORE THAN THE MINIMUM NUMBER OF DRINKING FOUNTAINS SPECIFIED IN 211.2 ARE PROVIDED, 50 PERCENT OF THE TOTAL NUMBER OF DRINKING FOUNTAINS PROVIDED SHALL COMPLY WITH 602.1 THROUGH 602.6, AND 50 PERCENT OF THE TOTAL NUMBER OF DRINKING FOUNTAINS PROVIDED SHALL COMPLY WITH 602.7.
 EXCEPTION: WHERE 50 PERCENT OF THE DRINKING FOUNTAINS BELONG TO A CATEGORY 20 PERCENT SHALL BE PERMITTED TO BE REQUIRED TO COMPLY WITH 211. EQUALS 100 PERCENT OF DRINKING FOUNTAINS COMPLYING WITH 211 EQUALS 100 PERCENT OF DRINKING FOUNTAINS.

CHAPTER 6: PLUMBING ELEMENTS AND FACILITIES
 601 GENERAL
 601.1 SCOPE. THE PROVISIONS OF CHAPTER 6 SHALL APPLY WHERE REQUIRED BY CHAPTER 2 OR WHERE REFERENCED BY A REQUIREMENT IN THIS CODE.
 602 DRINKING FOUNTAINS
 602.1 GENERAL. DRINKING FOUNTAINS SHALL COMPLY WITH 307 AND 602.
 602.2 CLEAR FLOOR SPACE. UNITS SHALL HAVE A CLEAR FLOOR OR GROUND SPACE COMPLYING WITH 305 POSITIONED FOR A FORWARD APPROACH AND CENTERED ON THE UNIT. KNEE AND TOE CLEARANCE COMPLYING WITH 306 SHALL BE PROVIDED.
 EXCEPTION: A PARALLEL APPROACH COMPLYING WITH 305 SHALL BE PERMITTED AT UNITS FOR CHILDREN'S USE WHERE THE SPOUT IS 30 INCHES (760 MM) MAXIMUM ABOVE THE FINISH FLOOR OR GROUND AND IS 3 TO 12 INCHES (95 MM) MAXIMUM FROM THE FRONT EDGE OF THE UNIT, INCLUDING BUMPERS.
 602.3 OPERABLE PARTS. OPERABLE PARTS SHALL COMPLY WITH 309.
 602.4 SPOUT HEIGHT. SPOUT OUTLETS SHALL BE 30 INCHES (760 MM) MAXIMUM ABOVE THE FINISH FLOOR OR GROUND.
 602.5 SPOUT LOCATION. THE SPOUT SHALL BE LOCATED 15 INCHES (380 MM) MINIMUM FROM THE VERTICAL SUPPORT AND 5 INCHES (125 MM) MAXIMUM FROM THE FRONT EDGE OF THE UNIT, INCLUDING BUMPERS.

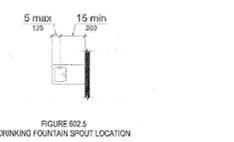

602.6 WATER FLOW. THE SPOUT SHALL PROVIDE A FLOW OF WATER 4 INCHES (100 MM) HIGH MINIMUM AND SHALL BE LOCATED 12 INCHES (305 MM) MAXIMUM FROM THE FRONT OF THE UNIT. THE ANGLE OF THE WATER STREAM SHALL BE MEASURED HORIZONTALLY RELATIVE TO THE FRONT FACE OF THE UNIT. WHERE SPOUTS ARE LOCATED LESS THAN 3 INCHES (75 MM) OF THE FRONT OF THE UNIT, THE ANGLE OF THE WATER STREAM SHALL BE 30 DEGREES MAXIMUM. WHERE SPOUTS ARE LOCATED BETWEEN 3 INCHES (75 MM) AND 5 INCHES (125 MM) MAXIMUM FROM THE FRONT OF THE UNIT, THE ANGLE OF THE WATER STREAM SHALL BE 15 DEGREES MAXIMUM.
 ADVISORY
 602.7 WATER FLOW. THE PURPOSE OF REGULATING THE DRINKING FOUNTAIN SPOUT TO PRODUCE A FLOW OF WATER 4 INCHES (100 MM) HIGH MINIMUM IS SO THAT A CUP CAN BE INSERTED UNDER THE FLOW OF WATER TO PROVIDE A DRINK OF WATER FOR AN INDIVIDUAL WHO, BECAUSE OF A DISABILITY, WOULD OTHERWISE BE INCAPABLE OF USING THE DRINKING FOUNTAIN.
 602.8 DRINKING FOUNTAINS FOR STANDING PERSONS. SPOUT OUTLETS OF DRINKING FOUNTAINS FOR STANDING PERSONS SHALL BE 38 INCHES (965 MM) MINIMUM AND 43 INCHES (1090 MM) MAXIMUM ABOVE THE FINISH FLOOR OR GROUND.

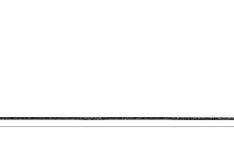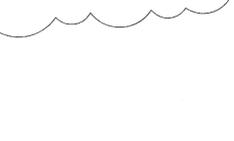

1009 SWIMMING POOLS, WADING POOLS, AND SPAS
 1009.1 General.
 Where provided, pool lifts, sloped entries, transfer walls, transfer systems, and pool stairs shall comply with 1009.
 1009.2 Pool Lifts.
 Pool lifts shall comply with 1009.2.
 Advisory 1009.2 Pool Lifts.
 There are a variety of seats available on pool lifts ranging from sling seats to those that are performed or molded. Pool lift seats with backs will enable a larger population of persons with disabilities to use the lift. Pool lift seats that consist of materials that resist corrosion and provide a firm base to transfer will be usable by a wider range of people with disabilities. Additional options such as armrests, head rests, seat belts, and leg support will enhance accessibility and better accommodate people with a wide range of disabilities.

1009.2.1 Pool Lift Location.
 Pool lifts shall be located where the water level does not exceed 48 inches (1220 mm).
 EXCEPTIONS:
 1. Where the entire pool depth is greater than 48 inches (1220 mm), compliance with 1009.2.1 shall not be required.
 2. Where multiple pool lift locations are provided, no more than one pool lift shall be required to be located in an area where the water level is 48 inches (1220 mm) maximum.

1009.2.2 Seat Location.
 In the raised position, the centerline of the seat shall be located over the deck and 16 inches (405 mm) minimum from the edge of the pool. The deck surface between the centerline of the seat and the pool edge shall have a slope not steeper than 1:48.
 1009.2.3 Clear Deck Space.
 On the side of the seat opposite the water, a clear deck space shall be provided parallel with the seat. The space shall be 38 inches (915 mm) wide minimum and shall extend forward 48 inches (1220 mm) minimum from a line located 12 inches (305 mm) behind the rear edge of the seat. The clear deck space shall have a slope not steeper than 1:48.

1009.2.4 Seat Height.
 The height of the lift seat shall be designed to allow a stop at 16 inches (405 mm) minimum to 19 inches (485 mm) maximum measured from the deck to the top of the seat surface when in the raised (lock) position.

1009.2.5 Seat Width.
 The seat shall be 16 inches (405 mm) wide minimum.
 1009.2.6 Footrests and Armrests.
 Footrests shall be provided and shall move with the seat. If provided, the armrest positioned opposite the water shall be removable or shall fold clear of the seat when the seat is in the raised (lock) position.
 EXCEPTION: Footrests shall not be required on pool lifts provided in spas.














1009.2.7 Operation.
 The lift shall be capable of unassisted operation from both the deck and water levels. Controls and operating mechanisms shall be unobstructed when the lift is in use and shall comply with 309.4.
 Advisory 1009.2.7 Operation.
 Pool lifts must be capable of unassisted operation from both the deck and water levels. This will permit a person to call the pool lift when the pool lift is in the opposite position. It is extremely important for a person who is swimming alone to be able to call the pool lift when it is in the up position so he or she will not be stranded in the water for extended periods of time awaiting assistance. The requirement for a pool lift to be independently operable does not preclude assistance from being provided.

1009.2.8 Submerged Depth.
 The lift shall be designed so that the seat will submerge to a water depth of 18 inches (455 mm) minimum below the stationary water level.

1009.2.9 Lifting Capacity.
 Single person pool lifts shall have a weight capacity of 300 pounds (136 kg) minimum and be capable of sustaining a static load of at least one and a half times the rated load.
 Advisory 1009.2.9 Lifting Capacity.
 Single person pool lifts must be capable of supporting a minimum weight of 300 pounds (136 kg) and sustaining a static load of at least one and a half times the rated load. Pool lifts should be provided that meet the needs of the population they serve. Providing a pool lift with a weight capacity greater than 300 pounds (136 kg) may be advisable.


1009.3 Sloped Entries.
 Sloped entries shall comply with 1009.3.
 Advisory 1009.3 Sloped Entries.
 Personal wheelchairs and mobility devices may not be appropriate for submerging in water. Some may have batteries, motors, and electrical systems that when submerged in water may cause damage to the personal mobility device or wheelchair or may contaminate the pool water. Providing an aquatic wheelchair made of non-corrosive materials and designed for access into the water will protect the water from contamination and avoid damage to personal wheelchairs or other mobility aids.

1009.3.1 Sloped Entries.
 Sloped entries shall comply with Chapter 4 except as modified in 1109.3.1 through 1109.3.3.
 EXCEPTION: Where sloped entries are provided, the surfaces shall not be required to be slip resistant.
 1009.3.2 Submerged Depth.
 Sloped entries shall extend to a depth of 24 inches (610 mm) minimum and 30 inches (760 mm) maximum below the stationary water level. Where landings are required by 405.7, at least one landing shall be located 24 inches (610 mm) minimum and 30 inches (760 mm) maximum below the stationary water level.
 EXCEPTION: In wading pools, the sloped entry and landings, if provided, shall extend to the deepest part of the wading pool.

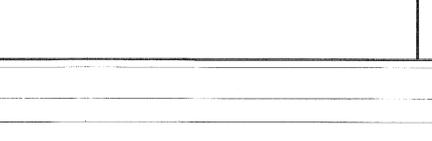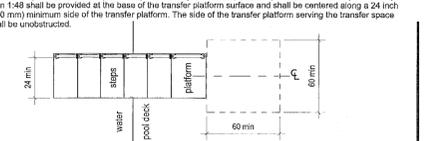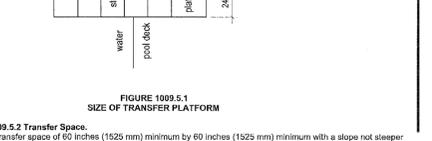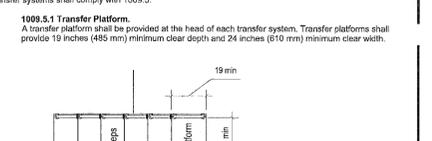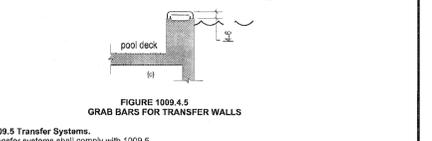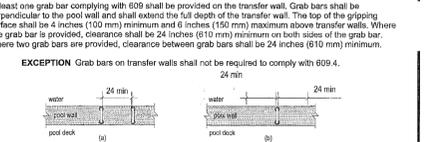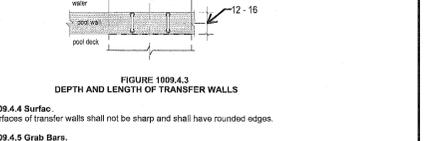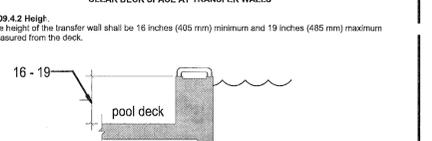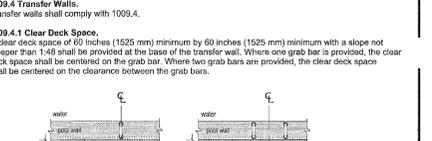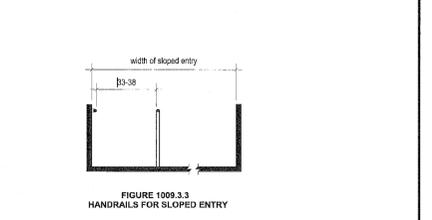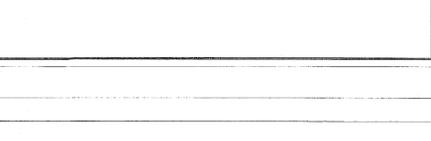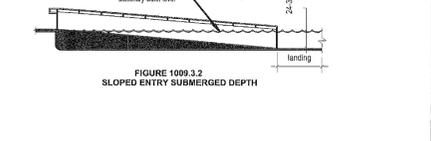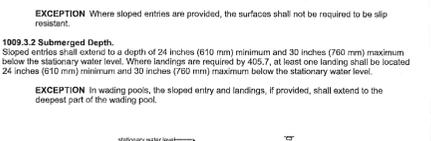


1009.5.3 Height.
 The height of the transfer platform shall comply with 1009.4.2.
 1009.5.4 Transfer Steps.
 Transfer step height shall be 8 inches (205 mm) maximum. The surface of the bottom tread shall extend to a water depth of 18 inches (455 mm) minimum below the stationary water level.
 Advisory 1009.5.4 Transfer Steps.
 Where possible, the height of the transfer step should be minimized to decrease the distance an individual is required to lift up or move down to reach the next step to gain access.

1009.5.5 Surface.
 The surface of the transfer system shall not be sharp and shall have rounded edges.
 1009.5.6 Size.
 Each transfer step shall have a tread clear depth of 14 inches (355 mm) minimum and 17 inches (430 mm) maximum and shall have a tread clear width of 24 inches (610 mm) minimum.

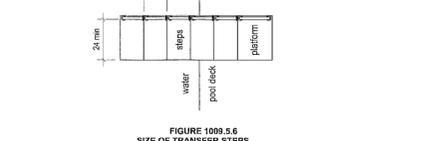

1009.5.7 Grab Bars.
 At least one grab bar on each transfer step and the transfer platform or a continuous grab bar serving each transfer step and the transfer platform shall be provided. Where a grab bar is provided on each step, the top of gripping surfaces shall be 4 inches (100 mm) minimum and 6 inches (150 mm) maximum above each step and transfer platform. Where a continuous grab bar is provided, the top of the gripping surface shall be 4 inches (100 mm) minimum and 6 inches (150 mm) maximum above the step rising and transfer platform. Grab bars shall comply with 609 and be located on at least one side of the transfer system. The grab bar located at the transfer platform shall not obstruct transfer.
 EXCEPTION: Grab bars on transfer systems shall not be required to comply with 609.4.

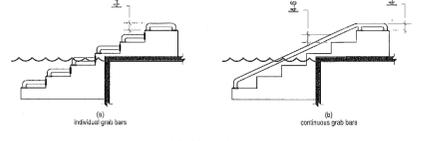

1009.6 Pool Stairs.
 Pool stairs shall comply with 1009.6.
 1009.6.1 Pool Stairs.
 Pool stairs shall comply with 504.
 EXCEPTION: Pool step rise heights shall not be required to be 4 inches (100 mm) high minimum and 7 inches (180 mm) high maximum provided that rise heights are uniform.
 1009.6.2 Handrail.
 The width between handrails shall be 20 inches (510 mm) minimum and 24 inches (610 mm) maximum. Handrail extensions required by 505.10.3 shall not be required on pool stairs.


City of Miami Beach
 Fire Prevention Division
 PLANS APPROVED

MTCI
 PRIVATE PROVIDER SERVICES, LLC
 Construction Plans Review, Inspections & Consulting

REVIEWER	INITIALS	DATE REVIEWED
BUILDING		9/29/17
STRUCTURAL		
MECHANICAL		
ELECTRICAL		
PLUMBING		
SITE CIVIL		

No.	DESCRIPTION	DATE
75% CD		01.18.17
BLDG. MTCI COMMENTS		08.01.17

PROJECT NO.	1613
DATE:	01.18.17
SHEET INDEX:	
SCALE:	As Noted
SHEET NO.	

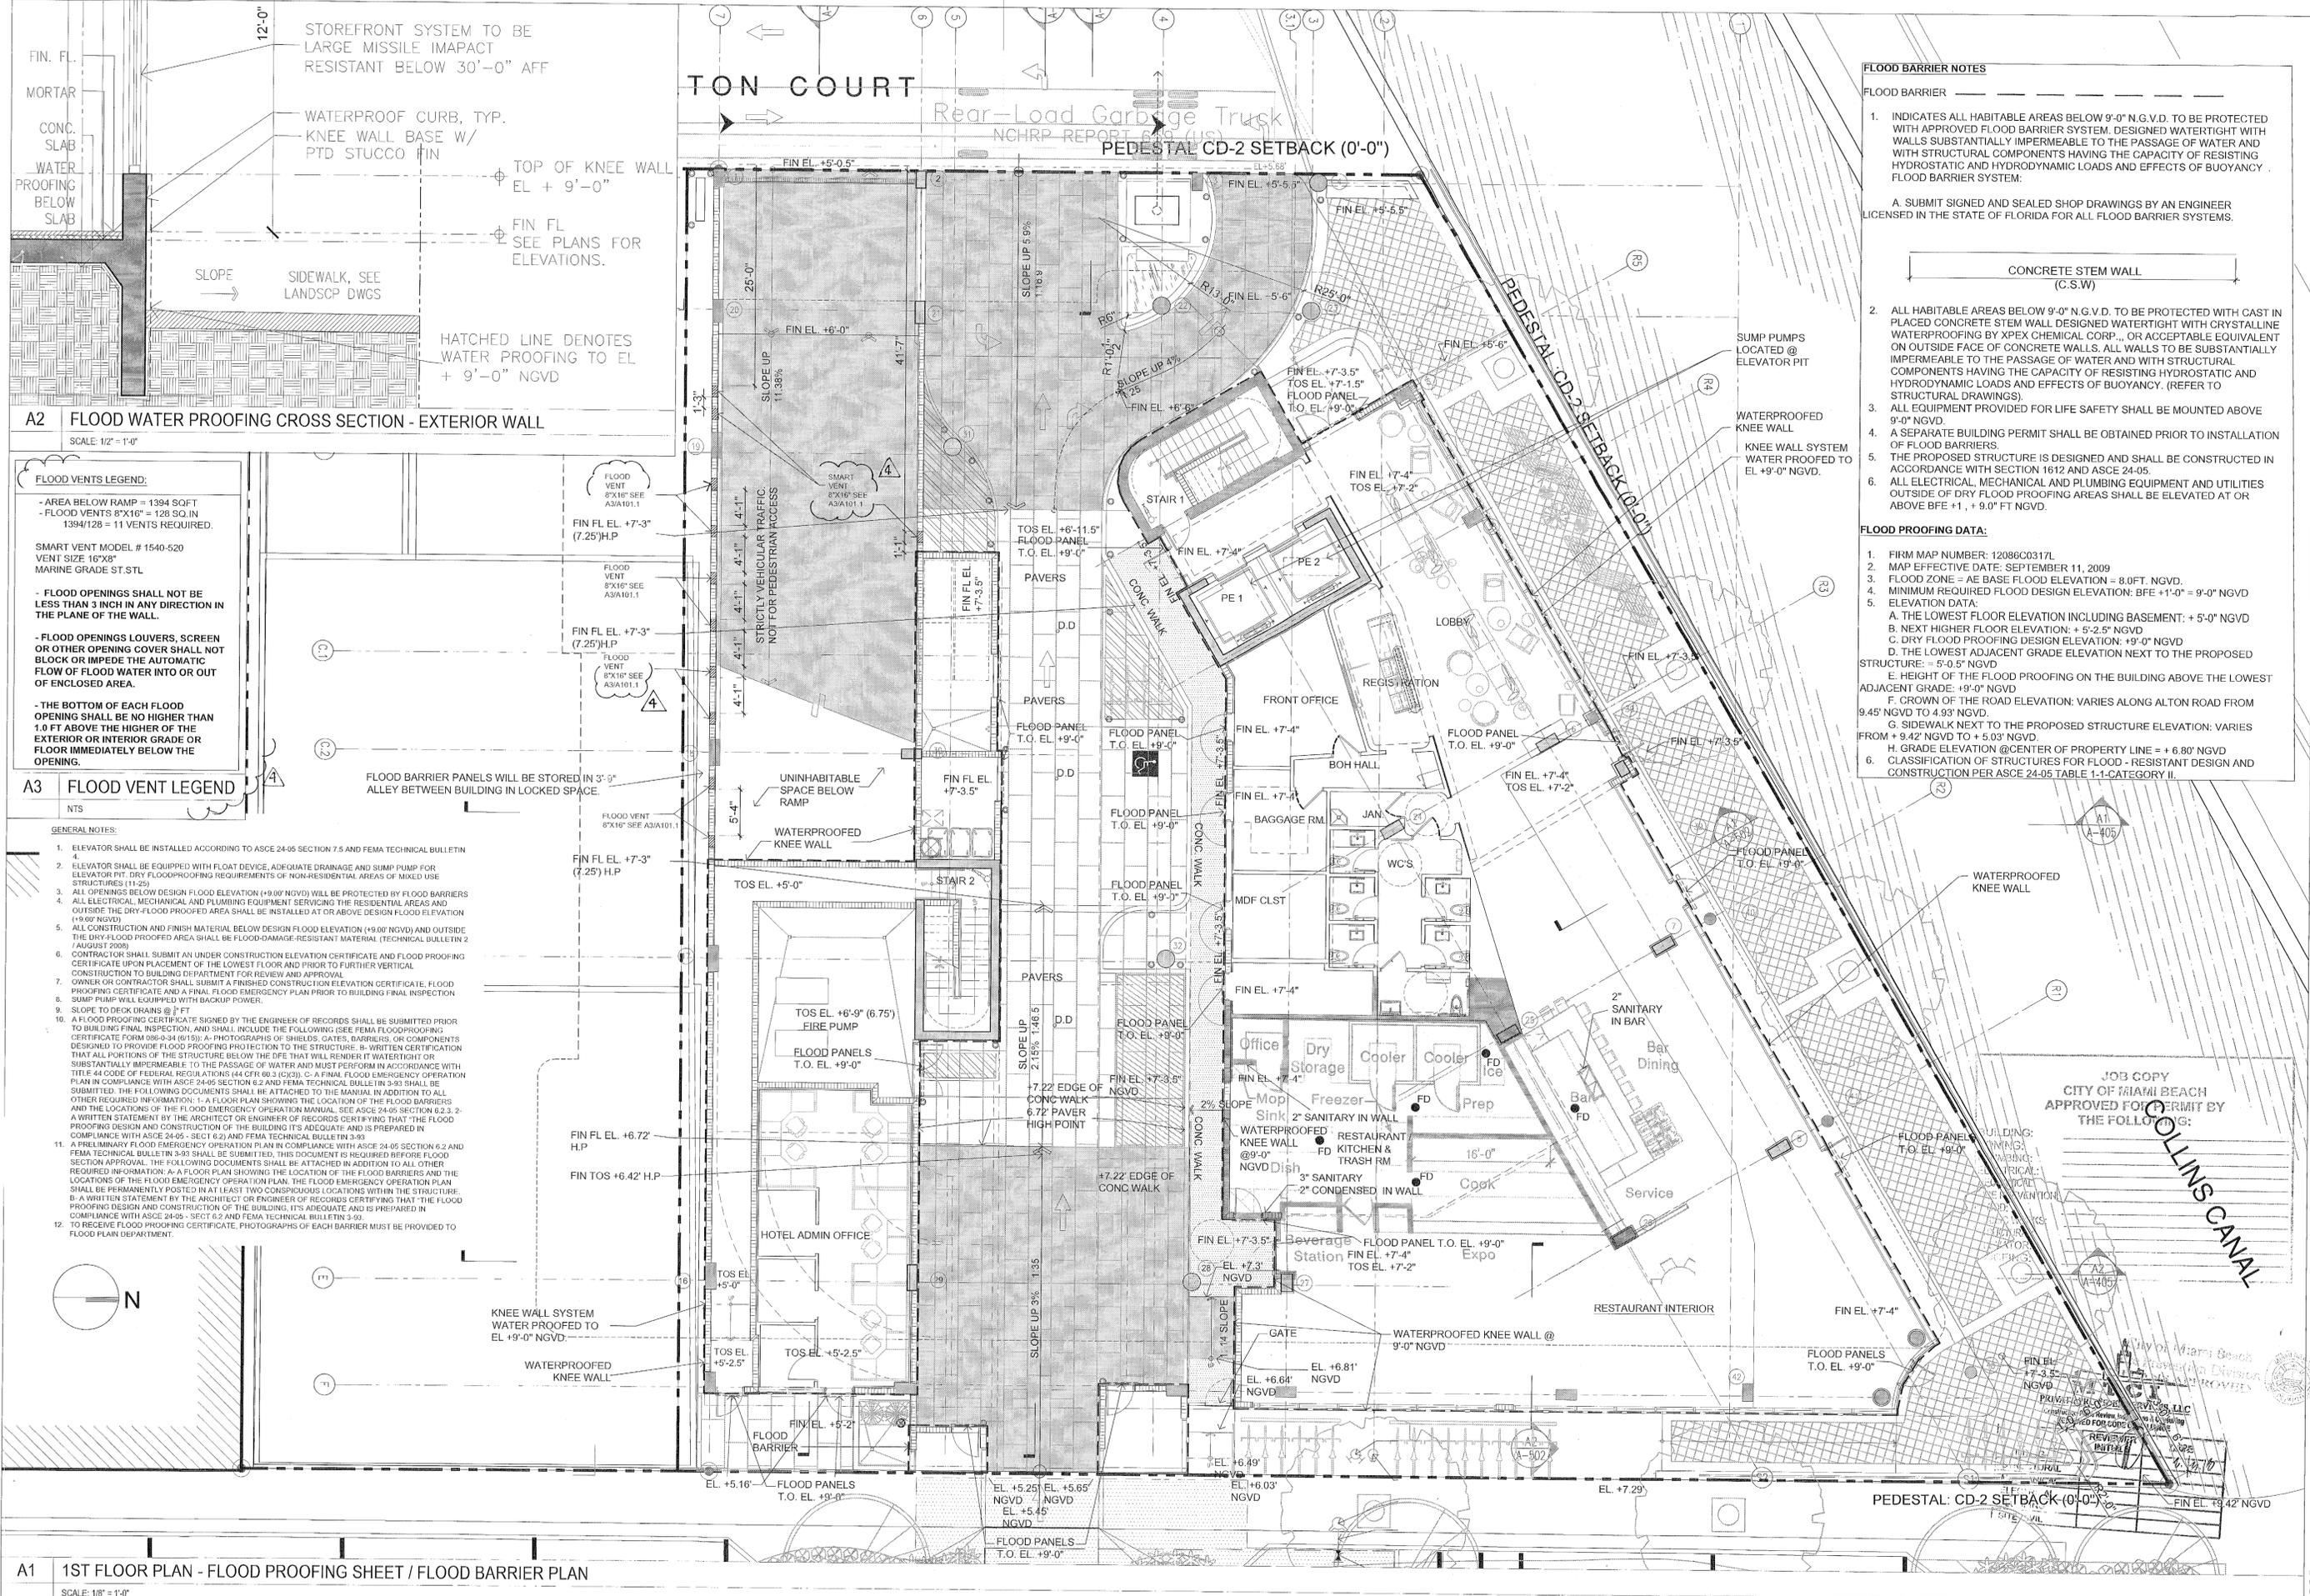

FLOOD BARRIER NOTES

FLOOD BARRIER

- INDICATES ALL HABITABLE AREAS BELOW 9'-0" N.G.V.D. TO BE PROTECTED WITH APPROVED FLOOD BARRIER SYSTEM. DESIGNED WATERTIGHT WITH WALLS SUBSTANTIALLY IMPERMEABLE TO THE PASSAGE OF WATER AND WITH STRUCTURAL COMPONENTS HAVING THE CAPACITY OF RESISTING HYDROSTATIC AND HYDRODYNAMIC LOADS AND EFFECTS OF BUOYANCY. FLOOD BARRIER SYSTEM:
- A. SUBMIT SIGNED AND SEALED SHOP DRAWINGS BY AN ENGINEER LICENSED IN THE STATE OF FLORIDA FOR ALL FLOOD BARRIER SYSTEMS.

CONCRETE STEM WALL (C.S.W)

- ALL HABITABLE AREAS BELOW 9'-0" N.G.V.D. TO BE PROTECTED WITH CAST IN PLACED CONCRETE STEM WALL DESIGNED WATERTIGHT WITH CRYSTALLINE WATERPROOFING BY XPEX CHEMICAL CORP., OR ACCEPTABLE EQUIVALENT ON OUTSIDE FACE OF CONCRETE WALLS. ALL WALLS TO BE SUBSTANTIALLY IMPERMEABLE TO THE PASSAGE OF WATER AND WITH STRUCTURAL COMPONENTS HAVING THE CAPACITY OF RESISTING HYDROSTATIC AND HYDRODYNAMIC LOADS AND EFFECTS OF BUOYANCY. (REFER TO STRUCTURAL DRAWINGS)
- ALL EQUIPMENT PROVIDED FOR LIFE SAFETY SHALL BE MOUNTED ABOVE 9'-0" NGVD.
- A SEPARATE BUILDING PERMIT SHALL BE OBTAINED PRIOR TO INSTALLATION OF FLOOD BARRIERS.
- THE PROPOSED STRUCTURE IS DESIGNED AND SHALL BE CONSTRUCTED IN ACCORDANCE WITH SECTION 1612 AND ASCE 24-05.
- ALL ELECTRICAL, MECHANICAL AND PLUMBING EQUIPMENT AND UTILITIES OUTSIDE OF DRY FLOOD PROOFING AREAS SHALL BE ELEVATED AT OR ABOVE BFE +1, + 9.0' FT NGVD.

FLOOD PROOFING DATA:

- FIRM MAP NUMBER: 12086C0317L
- MAP EFFECTIVE DATE: SEPTEMBER 11, 2009
- FLOOD ZONE = AE BASE FLOOD ELEVATION = 8.0 FT. NGVD.
- MINIMUM REQUIRED FLOOD DESIGN ELEVATION: BFE +1'-0" = 9'-0" NGVD
- ELEVATION DATA:
 - THE LOWEST FLOOR ELEVATION INCLUDING BASEMENT: + 5'-0" NGVD
 - NEXT HIGHER FLOOR ELEVATION: + 5'-2.5" NGVD
 - DRY FLOOD PROOFING DESIGN ELEVATION: +9'-0" NGVD
 - THE LOWEST ADJACENT GRADE ELEVATION NEXT TO THE PROPOSED STRUCTURE: = 5'-0.5" NGVD
 - HEIGHT OF THE FLOOD PROOFING ON THE BUILDING ABOVE THE LOWEST ADJACENT GRADE: +9'-0" NGVD
 - CROWN OF THE ROAD ELEVATION: VARIES ALONG ALTON ROAD FROM 9.45' NGVD TO 4.93' NGVD.
 - SIDEWALK NEXT TO THE PROPOSED STRUCTURE ELEVATION: VARIES FROM + 9.42' NGVD TO + 5.03' NGVD.
 - GRADE ELEVATION @ CENTER OF PROPERTY LINE = + 6.80' NGVD
 - CLASSIFICATION OF STRUCTURES FOR FLOOD - RESISTANT DESIGN AND CONSTRUCTION PER ASCE 24-05 TABLE 1-1-CATEGORY II.

A2 FLOOD WATER PROOFING CROSS SECTION - EXTERIOR WALL
SCALE: 1/2" = 1'-0"

FLOOD VENTS LEGEND:

- AREA BELOW RAMP = 1394 SQ FT
- FLOOD VENTS 8"X16" = 128 SQ. IN
- 1394/128 = 11 VENTS REQUIRED.

SMART VENT MODEL # 1540-520
VENT SIZE 10"X14"
MARINE GRADE ST.STL

FLOOD OPENINGS SHALL NOT BE LESS THAN 3 INCH IN ANY DIRECTION IN THE PLANE OF THE WALL.

FLOOD OPENINGS LOUVERS, SCREEN OR OTHER OPENING COVER SHALL NOT BLOCK OR IMPEDE THE AUTOMATIC FLOW OF FLOOD WATER INTO OR OUT OF ENCLOSED AREA.

THE BOTTOM OF EACH FLOOD OPENING SHALL BE NO HIGHER THAN 1.0 FT ABOVE THE HIGHER OF THE EXTERIOR OR INTERIOR GRADE OR FLOOR IMMEDIATELY BELOW THE OPENING.

A3 FLOOD VENT LEGEND
NTS

GENERAL NOTES:

- ELEVATOR SHALL BE INSTALLED ACCORDING TO ASCE 24-05 SECTION 7.5 AND FEMA TECHNICAL BULLETIN 4.
- ELEVATOR SHALL BE EQUIPPED WITH FLOOD DEVICE, ADEQUATE DRAINAGE AND SUMP PUMP FOR ELEVATOR PIT. DRY FLOODPROOFING REQUIREMENTS OF NON-RESIDENTIAL AREAS OF MIXED USE STRUCTURES (11-25)
- ALL OPENINGS BELOW DESIGN FLOOD ELEVATION (+9.00' NGVD) WILL BE PROTECTED BY FLOOD BARRIERS
- ALL ELECTRICAL, MECHANICAL AND PLUMBING EQUIPMENT SERVING THE RESIDENTIAL AREAS AND OUTSIDE THE DRY-FLOOD PROOFED AREA SHALL BE INSTALLED AT OR ABOVE DESIGN FLOOD ELEVATION (+9.00' NGVD)
- ALL CONSTRUCTION AND FINISH MATERIAL BELOW DESIGN FLOOD ELEVATION (+9.00' NGVD) AND OUTSIDE THE DRY-FLOOD PROOFED AREA SHALL BE FLOOD-DAMAGE-RESISTANT MATERIAL (TECHNICAL BULLETIN 2 AUGUST 2008)
- CONTRACTOR SHALL SUBMIT AN UNDER CONSTRUCTION ELEVATION CERTIFICATE AND FLOOD PROOFING CERTIFICATE UPON PLACEMENT OF THE LOWEST FLOOR AND PRIOR TO FURTHER VERTICAL CONSTRUCTION TO BUILDING DEPARTMENT FOR REVIEW AND APPROVAL
- OWNER OR CONTRACTOR SHALL SUBMIT A FINISHED CONSTRUCTION ELEVATION CERTIFICATE, FLOOD PROOFING CERTIFICATE AND A FINAL FLOOD EMERGENCY PLAN PRIOR TO BUILDING FINAL INSPECTION
- SUMP PUMP WILL BE EQUIPPED WITH BACKUP POWER.
- SLOPE TO DECK DRAINS @ 3 FT
- A FLOOD PROOFING CERTIFICATE SIGNED BY THE ENGINEER OF RECORDS SHALL BE SUBMITTED PRIOR TO BUILDING FINAL INSPECTION, AND SHALL INCLUDE THE FOLLOWING (SEE FEMA FLOODPROOFING CERTIFICATE FORM 0804-34 (8/15)): A- PHOTOGRAPHS OF SHIELDS, GATES, BARRIERS, OR COMPONENTS DESIGNED TO PROVIDE FLOOD PROOFING PROTECTION TO THE STRUCTURE; B- WRITTEN CERTIFICATION THAT ALL PORTIONS OF THE STRUCTURE BELOW THE DFE THAT WILL RENDER IT WATERTIGHT OR SUBSTANTIALLY IMPERMEABLE TO THE PASSAGE OF WATER AND MUST PERFORM IN ACCORDANCE WITH TITLE 44 CODE OF FEDERAL REGULATIONS (44 CFR 80.3 (C)(3)); C- A FINAL FLOOD EMERGENCY OPERATION PLAN IN COMPLIANCE WITH ASCE 24-05 SECTION 6.2 AND FEMA TECHNICAL BULLETIN 3-93 SHALL BE SUBMITTED. THE FOLLOWING DOCUMENTS SHALL BE ATTACHED TO THE MANUAL IN ADDITION TO ALL OTHER REQUIRED INFORMATION: 1- A FLOOR PLAN SHOWING THE LOCATION OF THE FLOOD BARRIERS AND THE LOCATIONS OF THE FLOOD EMERGENCY OPERATION MANUAL. SEE ASCE 24-05 SECTION 6.2.3. 2- A WRITTEN STATEMENT BY THE ARCHITECT OR ENGINEER OF RECORDS CERTIFYING THAT THE FLOOD PROOFING DESIGN AND CONSTRUCTION OF THE BUILDING IS ADEQUATE AND IS PREPARED IN COMPLIANCE WITH ASCE 24-05 - SECT 6.2 AND FEMA TECHNICAL BULLETIN 3-93
- A PRELIMINARY FLOOD EMERGENCY OPERATION PLAN IN COMPLIANCE WITH ASCE 24-05 SECTION 6.2 AND FEMA TECHNICAL BULLETIN 3-93 SHALL BE SUBMITTED. THIS DOCUMENT IS REQUIRED BEFORE FLOOD SECTION APPROVAL. THE FOLLOWING DOCUMENTS SHALL BE ATTACHED IN ADDITION TO ALL OTHER REQUIRED INFORMATION: A- A FLOOR PLAN SHOWING THE LOCATION OF THE FLOOD BARRIERS AND THE LOCATIONS OF THE FLOOD EMERGENCY OPERATION PLAN. THE FLOOD EMERGENCY OPERATION PLAN SHALL BE PERMANENTLY POSTED IN AT LEAST TWO CONSPICUOUS LOCATIONS WITHIN THE STRUCTURE. B- A WRITTEN STATEMENT BY THE ARCHITECT OR ENGINEER OF RECORDS CERTIFYING THAT THE FLOOD PROOFING DESIGN AND CONSTRUCTION OF THE BUILDING IS ADEQUATE AND IS PREPARED IN COMPLIANCE WITH ASCE 24-05 - SECT 6.2 AND FEMA TECHNICAL BULLETIN 3-93
- TO RECEIVE FLOOD PROOFING CERTIFICATE, PHOTOGRAPHS OF EACH BARRIER MUST BE PROVIDED TO FLOOD PLAN DEPARTMENT.

A1 1ST FLOOR PLAN - FLOOD PROOFING SHEET / FLOOD BARRIER PLAN
SCALE: 1/8" = 1'-0"

STATE OF FLORIDA
REGISTERED ARCHITECT
REGISTRATION #00009893

THESE DESIGNS AND DRAWINGS ARE THE
COPYRIGHTED PROPERTY OF PERMUY
ARCHITECTURE, INTERIOR DESIGN AND
PLANNING, INC. AND MAY NOT BE REPRODUCED
EXCEPT WITH SPECIFICATION WRITTEN
CONSENT OF THE ARCHITECT. THE
CONTRACTOR MUST CHECK AND VERIFY ALL
DIMENSIONS OF THE JOB AND BE RESPONSIBLE
FOR ANY ERRORS. REPORTING ANY DISCREPANCIES
TO THE ARCHITECT BEFORE COMMENCING WORK.
DRAWINGS ARE NOT TO BE SCALED.

STATE OF FLORIDA
REGISTERED ARCHITECT
REGISTRATION #00009893

STATE OF FLORIDA
REGISTERED ARCHITECT
REGISTRATION #00009893

KIMPTON HOTEL
PALOMAR
SOUTH BEACH
1750 Alton Road, Miami Beach, FL 33139
FINVARB GROUP
1085 Kane Concourse, Suite 201, Bay Harbor Island, FL 33154


JOB COPY
CITY OF MIAMI BEACH
APPROVED FOR PERMIT BY
THE FOLLOWING:

No.	DESCRIPTION	DATE
1	PERMIT SET	02.28.17
4	REV. 4	11.22.17

PROJECT NO: 1613
DATE: 02.28.17
SHEET INDEX

SCALE: As Noted
SHEET NO: A-101.1

ELECTRICAL VEHICLE REQUIREMENT.
 A minimum of two percent of the required off-street parking spaces, with a minimum of one parking space shall contain electric vehicle parking spaces, which are strictly reserved for the exclusive use of electric vehicles (Sec. 130-39). Electric vehicle parking spaces shall meet the standards set forth in Sec. 130-72. Electric vehicle parking spaces shall be painted green, or shall be marked by green painted lines or curbs. Each electric vehicle parking space shall be marked by a sign designating the parking space as an electric vehicle parking space, in accordance with the Manual on Uniform Traffic Control Devices (MUTCD) of the Federal Highway Administration. Each electric vehicle charging station shall be equipped with a sign that includes the following information: (i) Voltage and amperage levels; (ii) Any applicable usage fees; (iii) Safety information; and (iv) Contact information for the owner of the charging station, to allow a customer to report issues relating to the charging station. Electric vehicle charging stations shall contain a retraction device, coiled cord or a fixture to hang cords and connectors above the ground surface. Electric vehicle charging stations shall be screened from view from the right of way, with the exception of alley.

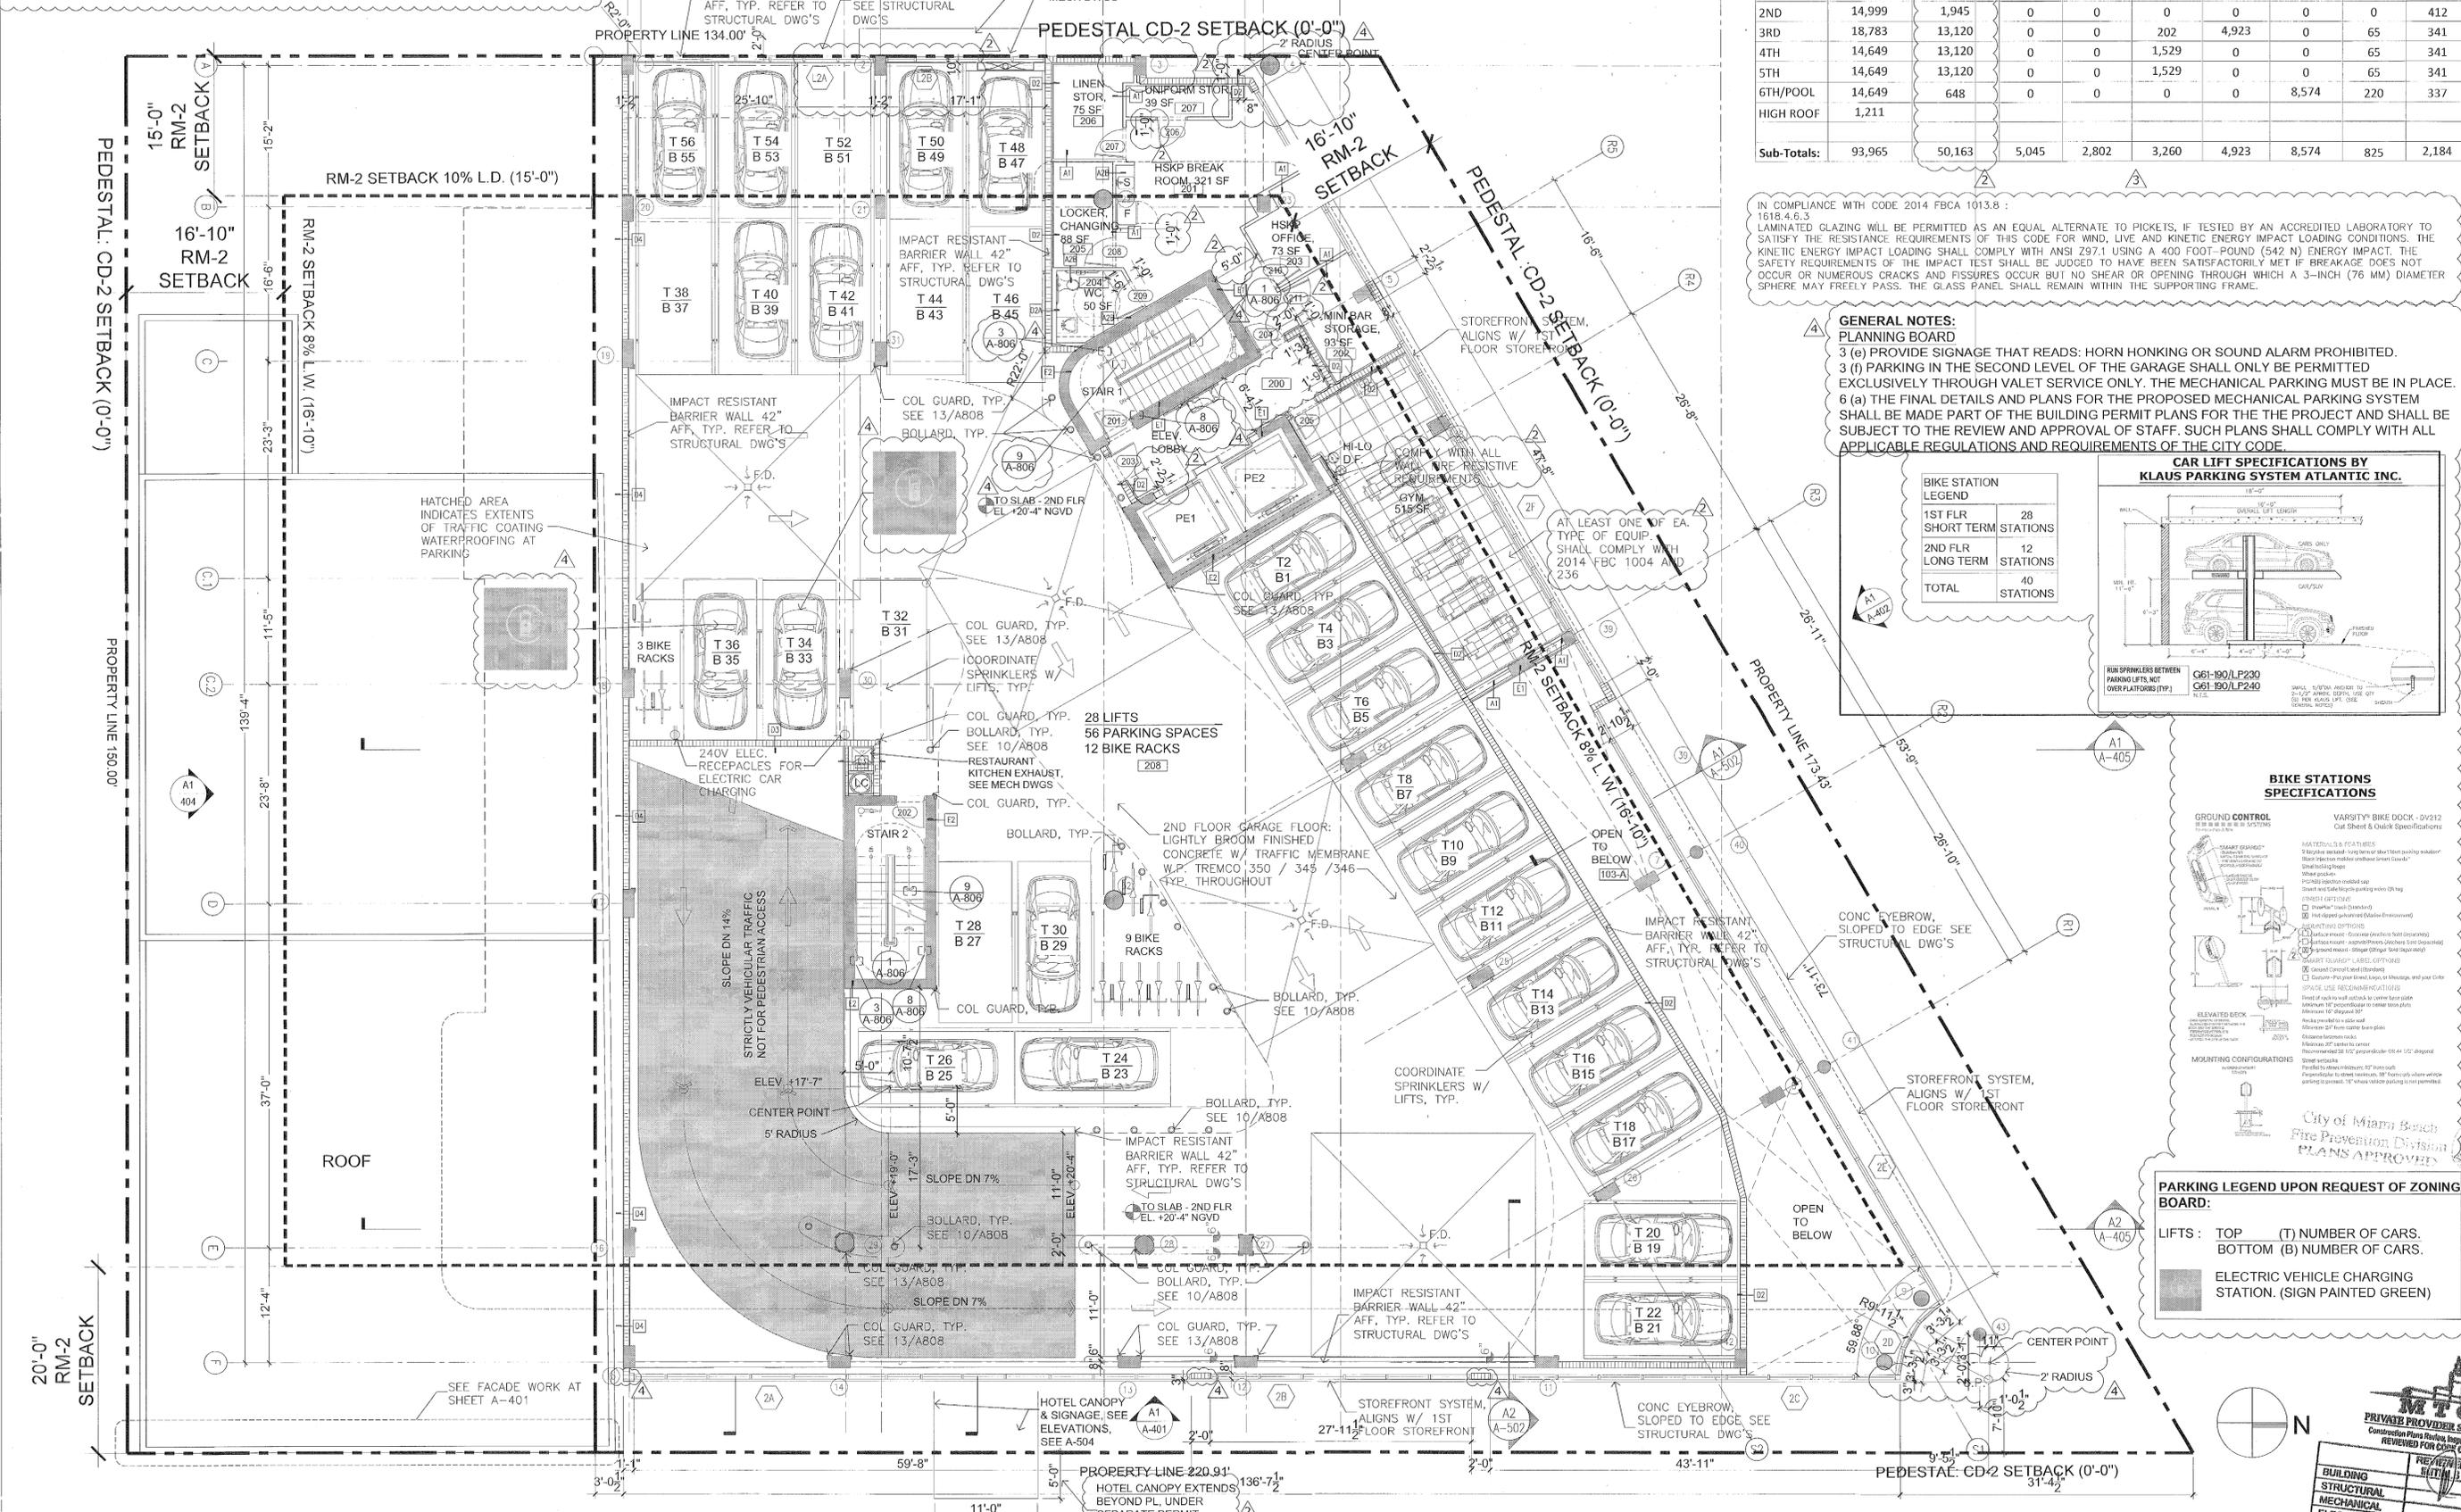


FLOOR	GROSS CONST AREA (SLAB AREA)	ENCLOSED AREA (A/C SPACE)	ENTRY DRIVE	CANAL WALKWAY	BALCONY	TERRACE	POOL DECK (FIN. DECK)	MECH ROOMS	STAIRS
1ST	15,025	8,210	5,045	2,802	0	0	0	410	412
2ND	14,999	1,945	0	0	0	0	0	0	412
3RD	18,783	13,120	0	0	202	4,923	0	65	341
4TH	14,649	13,120	0	0	1,529	0	0	65	341
5TH	14,649	13,120	0	0	1,529	0	0	65	341
6TH/POOL	14,649	648	0	0	0	0	8,574	220	337
HIGH ROOF	1,211								
Sub-Totals:	93,965	50,163	5,045	2,802	3,260	4,923	8,574	825	2,184

IN COMPLIANCE WITH CODE 2014 FBCA 1013.8 : 1618.4.6.3
 LAMINATED GLAZING WILL BE PERMITTED AS AN EQUAL ALTERNATE TO PICKETS, IF TESTED BY AN ACCREDITED LABORATORY TO SATISFY THE RESISTANCE REQUIREMENTS OF THIS CODE FOR WIND, LIVE, AND KINETIC ENERGY IMPACT LOADING CONDITIONS. THE KINETIC ENERGY IMPACT LOADING SHALL COMPLY WITH ANSI Z97.1 USING A 400 FOOT-POUND (542 N) ENERGY IMPACT. THE SAFETY REQUIREMENTS OF THE IMPACT TEST SHALL BE JUDGED TO HAVE BEEN SATISFACTORILY MET IF BREAKAGE DOES NOT OCCUR OR NUMEROUS CRACKS AND FISSURES OCCUR BUT NO SHEAR OR OPENING THROUGH WHICH A 3-INCH (76 MM) DIAMETER SPHERE MAY FREELY PASS. THE GLASS PANEL SHALL REMAIN WITHIN THE SUPPORTING FRAME.

GENERAL NOTES:
PLANNING BOARD
 3 (e) PROVIDE SIGNAGE THAT READS: HORN HONKING OR SOUND ALARM PROHIBITED.
 3 (f) PARKING IN THE SECOND LEVEL OF THE GARAGE SHALL ONLY BE PERMITTED EXCLUSIVELY THROUGH VALET SERVICE ONLY. THE MECHANICAL PARKING MUST BE IN PLACE.
 6 (a) THE FINAL DETAILS AND PLANS FOR THE PROPOSED MECHANICAL PARKING SYSTEM SHALL BE MADE PART OF THE BUILDING PERMIT PLANS FOR THE PROJECT AND SHALL BE SUBJECT TO THE REVIEW AND APPROVAL OF STAFF. SUCH PLANS SHALL COMPLY WITH ALL APPLICABLE REGULATIONS AND REQUIREMENTS OF THE CITY CODE.

BIKE STATION LEGEND

1ST FLR SHORT TERM STATIONS	28
2ND FLR LONG TERM STATIONS	12
TOTAL STATIONS	40

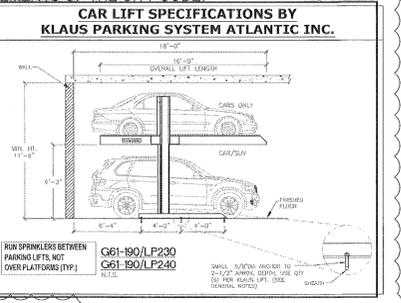

PARKING LEGEND UPON REQUEST OF ZONING BOARD:
 LIFTS: TOP (T) NUMBER OF CARS. BOTTOM (B) NUMBER OF CARS.
 ELECTRIC VEHICLE CHARGING STATION. (SIGN PAINTED GREEN)

PERMUY
 ARCHITECTURE
 INTERIOR DESIGN
 PLANNING
 2717 Ponce de Leon Blvd.
 Coral Gables, FL 33134
 Phone: 305.200.5302
 www.PermuyArchitecture.com

STATE OF FLORIDA
 REAL ESTATE ARCHITECT
 REGISTRATION #A0000953
 THESE DESIGNS AND DRAWINGS ARE THE
 COPYRIGHTED PROPERTY OF PERMUY
 ARCHITECTURE, INTERIOR DESIGN AND
 PLANNING, INC. AND MAY NOT BE REPRODUCED
 EXCEPT WITH SPECIFICATION WRITTEN
 CONSENT OF THE ARCHITECT. THE
 CONTRACTOR SHALL VERIFY ALL
 DIMENSIONS OF THE JOB AND BE RESPONSIBLE
 FOR SAME. REPORTING ANY DISCREPANCIES TO
 THE ARCHITECT BEFORE COMMENCING WORK.
 DRAWINGS ARE NOT TO BE SCALED

KIMTOWN HOTEL
PALOMAR
 SOUTH BEACH
 1750 Alton Road, Miami Beach, FL 33139
FINVARB GROUP
 1065 Kane Concourse, Suite 201, Bay Harbor Islands, FL 33154

Project: _____ Owner: _____

No.	DESCRIPTION	DATE
1	PERMIT SET	02.28.17
2	REV. 2 BLDG. MITL COMMENTS	05.31.17
3	REV. 3 BLDG. MITL COMMENTS	08.01.17
4	REV. 4 BLDG. MITL COMMENTS	11.22.17

PROJECT NO. 1613 DATE: 12.01.17

City of Miami Beach
 Fire Prevention Division
 PLANS APPROVED

MUTCD
 PRIVATE PROVIDER REVIEWED
 Construction Plans Reviewed and Approved by Consulting Engineer for Code Compliance

BUILDING	REVIEWED	DATE: As Noted
STRUCTURAL	REVIEWED	DATE: As Noted
MECHANICAL	REVIEWED	DATE: As Noted
ELECTRICAL	REVIEWED	DATE: As Noted
PLUMBING	REVIEWED	DATE: As Noted
SITE CIVIL	REVIEWED	DATE: As Noted

A-102

FLOOR	GROSS CONST AREA (SLAB AREA)	ENCLOSED AREA (A/C SPACE)	ENTRY DRIVE	CANAL WALKWAY	BALCONY	TERRACE	POOL DECK (FIN. DECK)	MECH ROOMS	STAIRS
1ST	15,025	8,210	5,045	2,802	0	0	0	410	412
2ND	14,999	1,945	0	0	0	0	0	0	412
3RD	18,783	13,120	0	0	202	4,923	0	65	341
4TH	14,649	13,120	0	0	1,529	0	0	65	341
5TH	14,649	13,120	0	0	1,529	0	0	65	341
6TH/POOL	14,649	648	0	0	0	0	8,574	220	337
HIGH ROOF	1,211								
Sub-Totals:	93,965	50,163	5,045	2,802	3,260	4,923	8,574	825	2,184

ADA ROOM LOCATIONS
As required per Florida Bldg Code Table 224.2

FLOOR	ROOM NUM.	ROOM TYPE	REQUIRED
3RD	309, 317, 322	A-C4, B-C2, B3	3 ROOMS
4TH	422	B-C2	1 ROOM
5TH	517, 522	B-C2, B3	2 ROOMS
			6 RMS TOT.

HEARING IMPAIRED ROOM LOCATIONS
As required per Florida Bldg Code Table 224.4

FLOOR	ROOM NUM.	ROOM TYPE	REQUIRED
3RD	309, 322, 328	A-C4, B-C2, AR-1	3 ROOMS
4TH	409, 422, 428	A-C4, B-C2, AR-1	3 ROOMS
5TH	509, 522, 528	A-C4, B-C2, AR-1	3 ROOMS
			9 RMS TOT.

IN COMPLIANCE WITH CODE 2014 FBCA 1013.8 : 1518.4.6.3 LAMINATED GLAZING WILL BE PERMITTED AS AN EQUAL ALTERNATE TO PICKETS, IF TESTED BY AN ACCREDITED LABORATORY TO SATISFY THE RESISTANCE REQUIREMENTS OF THIS CODE FOR WIND, LIVE AND KINETIC ENERGY IMPACT LOADING CONDITIONS. THE KINETIC ENERGY IMPACT LOADING SHALL COMPLY WITH ANSI 297.1 USING A 400 FOOT-POUND (542 N) ENERGY IMPACT. THE SAFETY REQUIREMENTS OF THE IMPACT TEST SHALL BE JUDGED TO HAVE BEEN SATISFACTORILY MET IF BREAKAGE DOES NOT OCCUR OR NUMEROUS CRACKS AND FISSURES OCCUR BUT NO SHEAR OR OPENING THROUGH WHICH A 3-INCH (76 MM) DIAMETER SPHERE MAY FREELY PASS. THE GLASS PANEL SHALL REMAIN WITHIN THE SUPPORTING FRAME.

NOTE: POLYIMIDE HS EPOXY COATING (WALLS) & EUCOPOXY TUF COATING ON FLOORS ELECTRICAL ROOM AND HSK (HOUSEKEEPING)

WATERPROOFING NOTES:
IN COMPLIANCE WITH CODE 2014 FBC 1519.16 : WATERPROOFING SYSTEMS MAY BE INSTALLED IN LIEU OF AN APPROVED ROOF SYSTEM OVER SLOPED OR HORIZONTAL DECKS SPECIFICALLY DESIGNED FOR PEDESTRIAN AND/OR VEHICULAR TRAFFIC, WHETHER THE DECK IS ABOVE OCCUPIED OR UNOCCUPIED SPACE. IN NEW CONSTRUCTION, THE MINIMUM DECK SLOPE SHALL BE 1/4:12.

1519.16.1 THE WATERPROOFING SYSTEM MUST POSSESS A CURRENT AND VALID PRODUCT APPROVAL.

1519.16.2 IF AN OVERBURDEN OR WEARING SURFACE IS NOT TO BE INSTALLED, THE WATERPROOFING SYSTEM MUST BE APPROVED BY THE MANUFACTURER FOR USE IN VEHICULAR AND/OR PEDESTRIAN TRAFFIC LOCATIONS.

1519.16.3 RESERVED.

1519.16.4 IF ANY PORTION OF THE WATERPROOFING MEMBRANE IS TO REMAIN EXPOSED, THE WATERPROOFING SYSTEM SHALL BE ULTRAVIOLET RESISTANT.

1519.16.5 FLASHINGS MUST BE INSTALLED IN ACCORDANCE WITH THE WATERPROOFING MANUFACTURER'S PUBLISHED SPECIFICATIONS AND IN COMPLIANCE WITH THE MATERIAL AND ATTACHMENT STANDARDS OF RAS 111.

1519.16.6 THE WATERPROOFING SYSTEM SHALL BE FLOOD-TESTED IN ACCORDANCE WITH ASTM D 5957.

1519.16.6.1 THE FLOOD TEST SHALL TAKE PLACE AFTER INSTALLATION OF THE WATERPROOFING MEMBRANE AND PRIOR TO THE INSTALLATION OF ANY ABOVE MEMBRANE COMPONENTS, WEARING SURFACE OR OVERBURDEN.

1519.16.6.2 AN APPROVED TESTING LAB SHALL PROVIDE WRITTEN VERIFICATION TO THE BUILDING OFFICIAL CONFIRMING THAT THE FLOOD TEST WAS PERFORMED ALONG WITH THE RESULTS, PRIOR TO FINAL INSPECTION.

Handwritten: 11-22-17

STATE OF FLORIDA
REGISTERED ARCHITECT
REGISTRATION #AR000953


THESE DESIGNS AND DRAWINGS ARE THE COPYRIGHTED PROPERTY OF PERMUY ARCHITECTURE, INC. AND MAY NOT BE REPRODUCED OR TRANSMITTED IN ANY FORM OR BY ANY MEANS, ELECTRONIC OR MECHANICAL, WITHOUT THE WRITTEN CONSENT OF THE ARCHITECT. THE CONTRACTOR MUST CHECK AND VERIFY ALL DIMENSIONS OF THE JOB AND BE RESPONSIBLE FOR SAME. REPORTING ANY DISCREPANCIES TO THE ARCHITECT BEFORE COMMENCING WORK. DRAWINGS ARE NOT TO BE SCALED.

KIMPTON HOTEL
PALOMAR
10-11TH FLOOR
1750 Alton Road, Miami Beach, FL 33139
FINVARB GROUP
1085 Kane Concourse, Suite 201, Bay Harbor Island, FL 33154

No.	DESCRIPTION	DATE
1	PERMIT SET	02.28.17
2	REV. 2	05.31.17
3	BLDG. MTCI COMMENTS	08.01.17
4	REV. 4	11.22.17

City of Miami Beach
Fire Prevention Division
PLANS APPROVED
PRIVATE PROVIDER SERVICES
Construction Plan Review, Inspections & Enforcement
REVIEWED FOR CODE COMPLIANCE

PROJECT NO. 1613
DATE: 02.28.17
SHEET INDEX
SCALE: As Noted
SHEET NO.

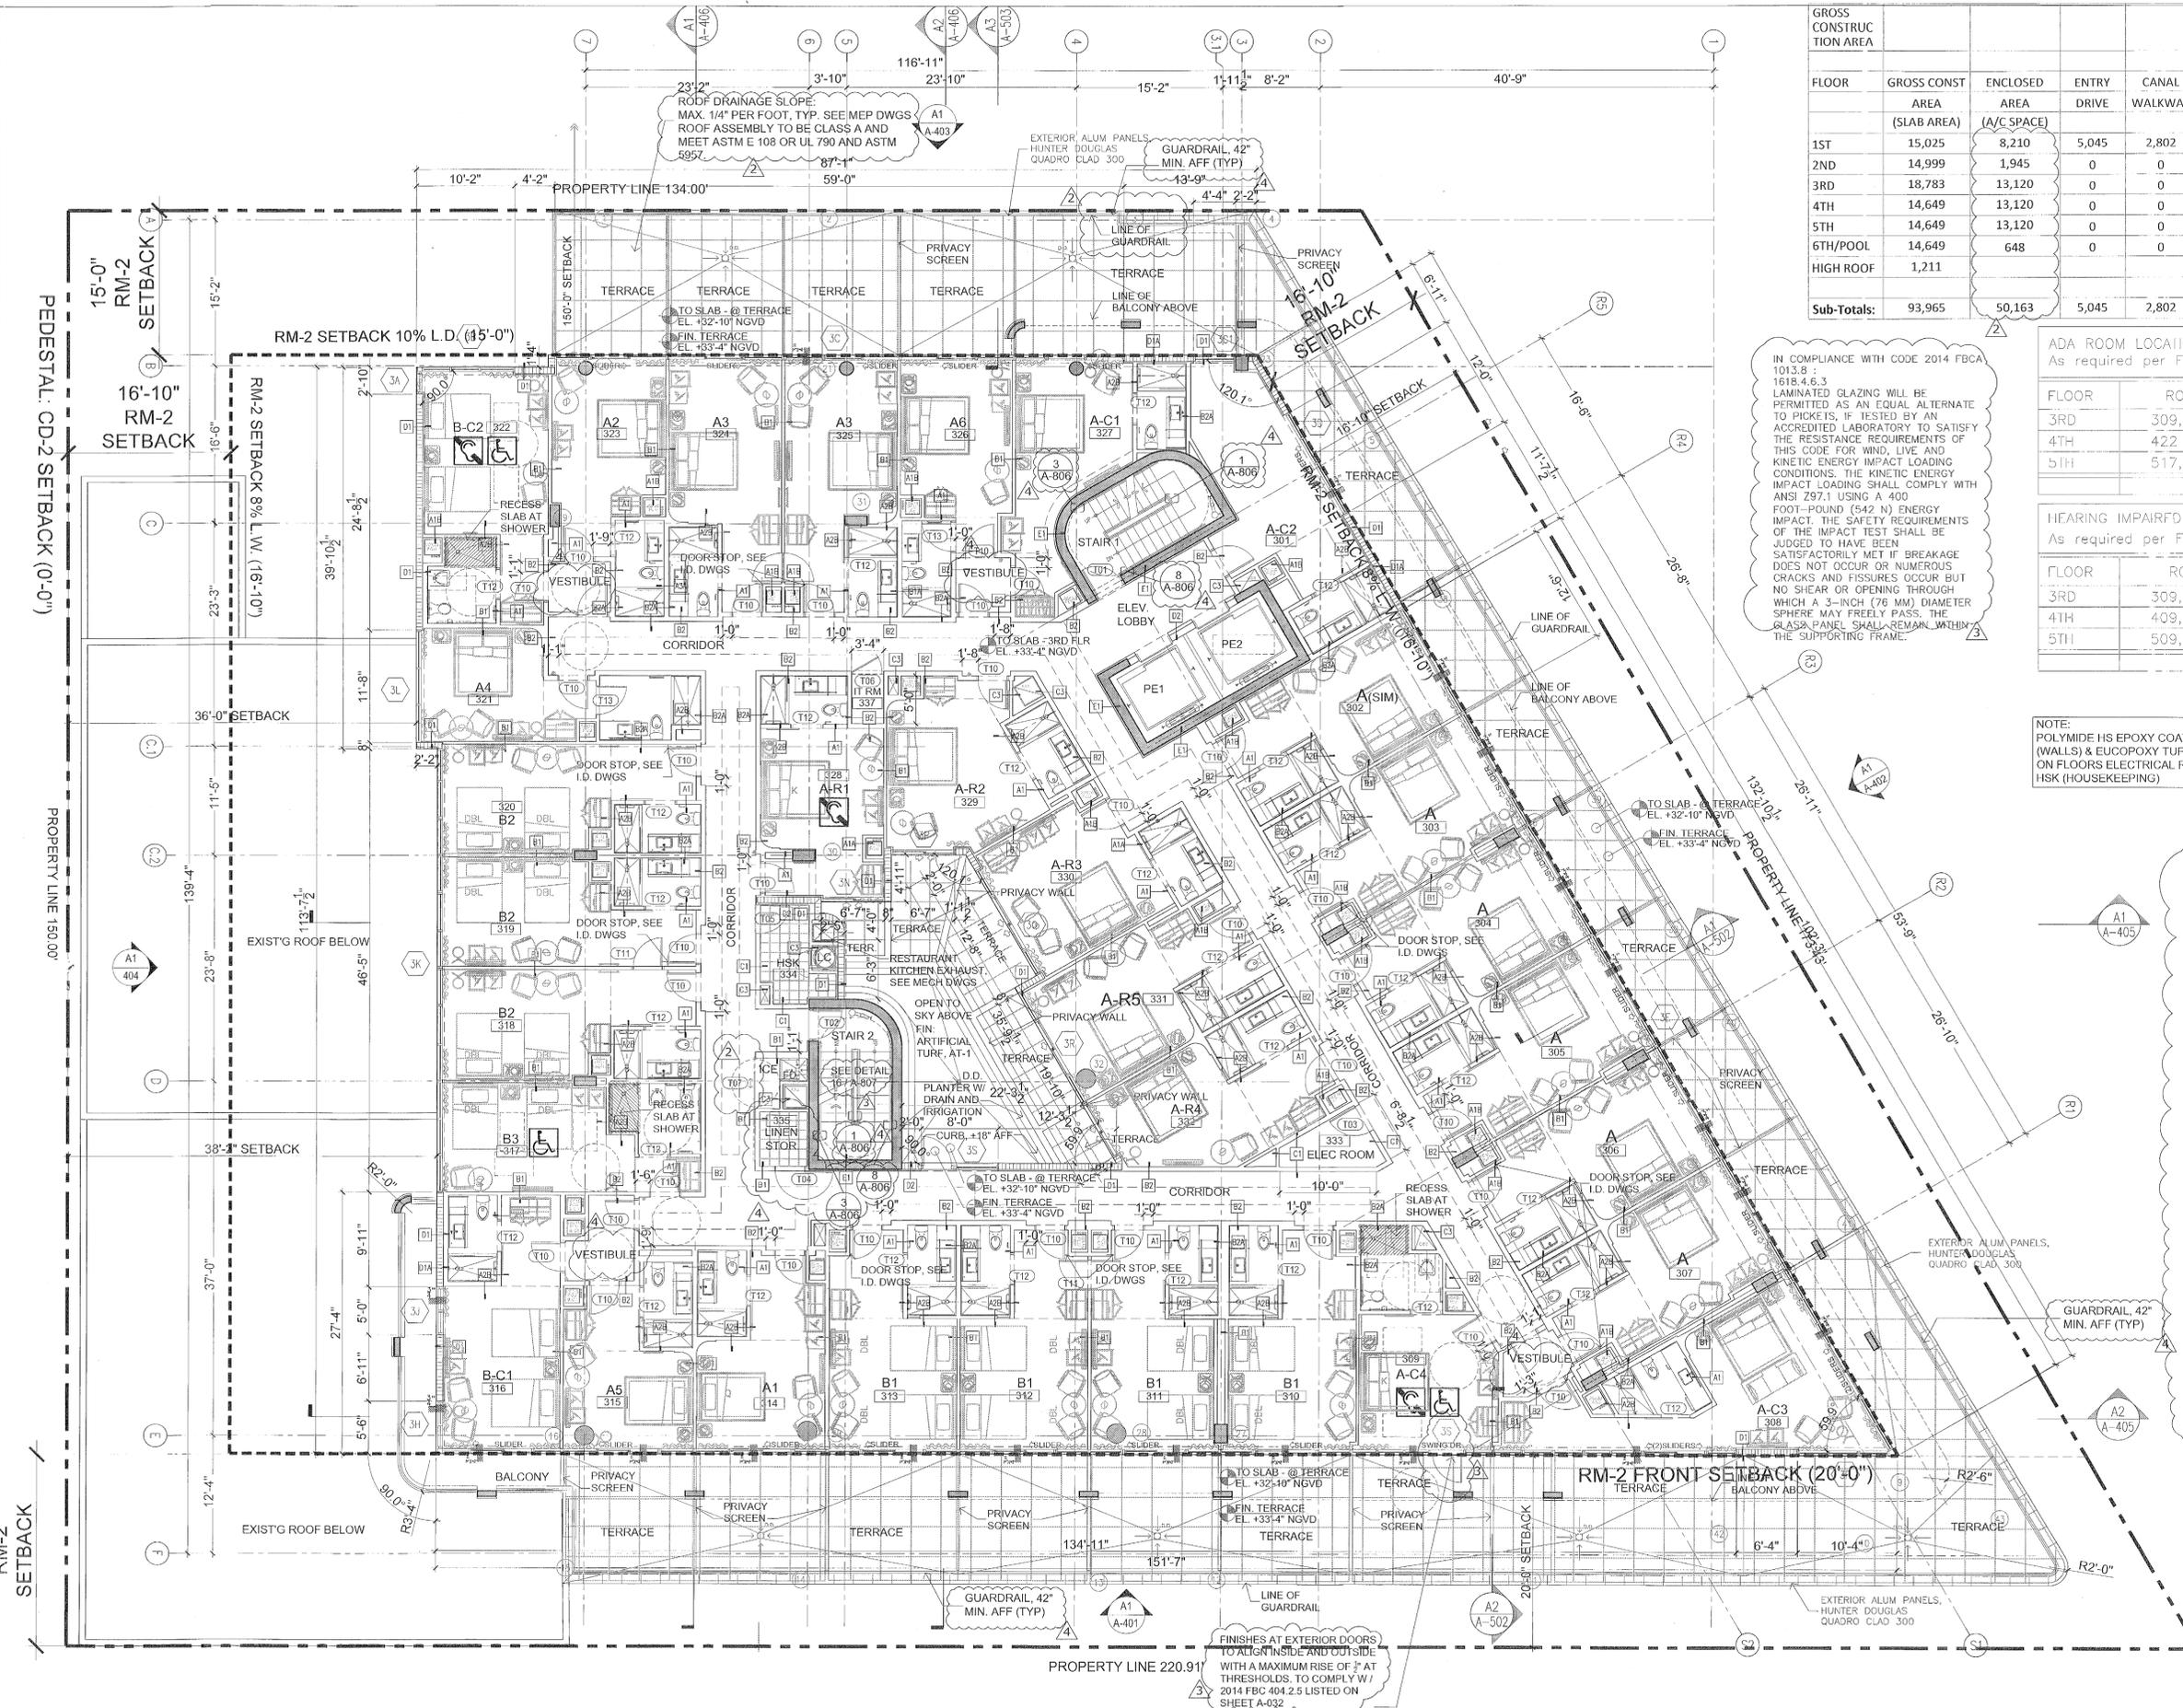

Walter Velazquez
11.22.17

FLOOR	GROSS CONSTRUC TION AREA		ENTRY DRIVE	CANAL WALKWAY	BALCONY	TERRACE	POOL DECK (FIN. DECK)	MECH ROOMS	STAIRS
	AREA (SLAB AREA)	ENCLOSED AREA (A/C SPACE)							
1ST	15,025	8,210	5,045	2,802	0	0	0	410	412
2ND	14,999	1,945	0	0	0	0	0	0	412
3RD	18,783	13,120	0	0	202	4,923	0	65	341
4TH	14,649	13,120	0	0	1,529	0	0	65	341
5TH	14,649	13,120	0	0	1,529	0	0	65	341
6TH/POOL	14,649	648	0	0	0	0	8,574	220	337
HIGH ROOF	1,211								
Sub-Totals:	93,965	50,163	5,045	2,802	3,260	4,923	8,574	825	2,184

ADA ROOM LOCATIONS
As required per Florida Bldg Code Table 224.2
REQUIRED 5 ROOMS

FLOOR	ROOM NUM.	ROOM TYPE	REQUIRED
3RD	309, 317, 322	A-C4, B-C2, B3	3 ROOMS
4TH	422	B-C2	1 ROOM
5TH	517, 522	B-C2, B3	2 ROOMS
			6 RMS TOT.

HEARING IMPAIRED ROOM LOCATIONS
As required per Florida Bldg Code Table 224.4
REQUIRED 9 ROOMS

FLOOR	ROOM NUM.	ROOM TYPE	REQUIRED
3RD	309, 322, 328	A-C4, B-C2, AR-1	3 ROOMS
4TH	409, 422, 428	A-C4, B-C2, AR-1	3 ROOMS
5TH	509, 522, 528	A-C4, B-C2, AR-1	3 ROOMS
			9 RMS TOT.

NOTE:
POLYIMIDE HS EPOXY COATING
(WALLS) & EUCOPOXY TUF COATING
ON FLOORS ELECTRICAL ROOM AND
HSK (HOUSEKEEPING)

IN COMPLIANCE WITH CODE 2014 FBCA 1013.8 :
1618.4.6.3
LAMINATED GLAZING WILL BE PERMITTED AS AN
EQUAL ALTERNATE TO PICKETS, IF TESTED BY AN
ACCREDITED LABORATORY TO SATISFY THE
RESISTANCE REQUIREMENTS OF THIS CODE FOR WIND,
LIVE AND KINETIC ENERGY IMPACT LOADING
CONDITIONS. THE KINETIC ENERGY IMPACT LOADING
SHALL COMPLY WITH ANSI Z97.1 USING A 400
FOOT-POUND (542 N) ENERGY IMPACT. THE SAFETY
REQUIREMENTS OF THE IMPACT TEST SHALL BE
JUDGED TO HAVE BEEN SATISFACTORILY MET IF
BREAKAGE DOES NOT OCCUR OR NUMEROUS CRACKS
AND FISSURES OCCUR BUT NO SHEAR OR OPENING
THROUGH WHICH A 3-INCH (76 MM) DIAMETER
SPHERE MAY FREELY PASS. THE GLASS PANEL
SHALL REMAIN WITHIN THE SUPPORTING FRAME.

PRIVATE REVIEW SERVICES, LLC
Construction Plans Review, Inspections & Consulting
REVISIONS FOR PERMIT SUBMITTANCE


REVISION	DATE
1	02/28/17
2	05/31/17
3	08/01/17
4	11/22/17

City of Miami Beach
Fire Prevention Division
PLANS APPROVED

No.	DESCRIPTION	DATE
1	PERMIT SET	02.28.17
2	BLDG. MTCI	05.31.17
3	COMMENTS	08.01.17
4	REV. 4	11.22.17

PROJECT NO: 1613
DATE: 02.28.17
SHEET INDEX:
SCALE: As Noted
SHEET NO:

KIAMTON HOTEL
PALOMAR
SOUTH BEACH
1750 Alton Road, Miami Beach, FL 33139
FINVARB GROUP
1005 N.W. Concourse, Suite 201, Day Harbor Island, FL 33154

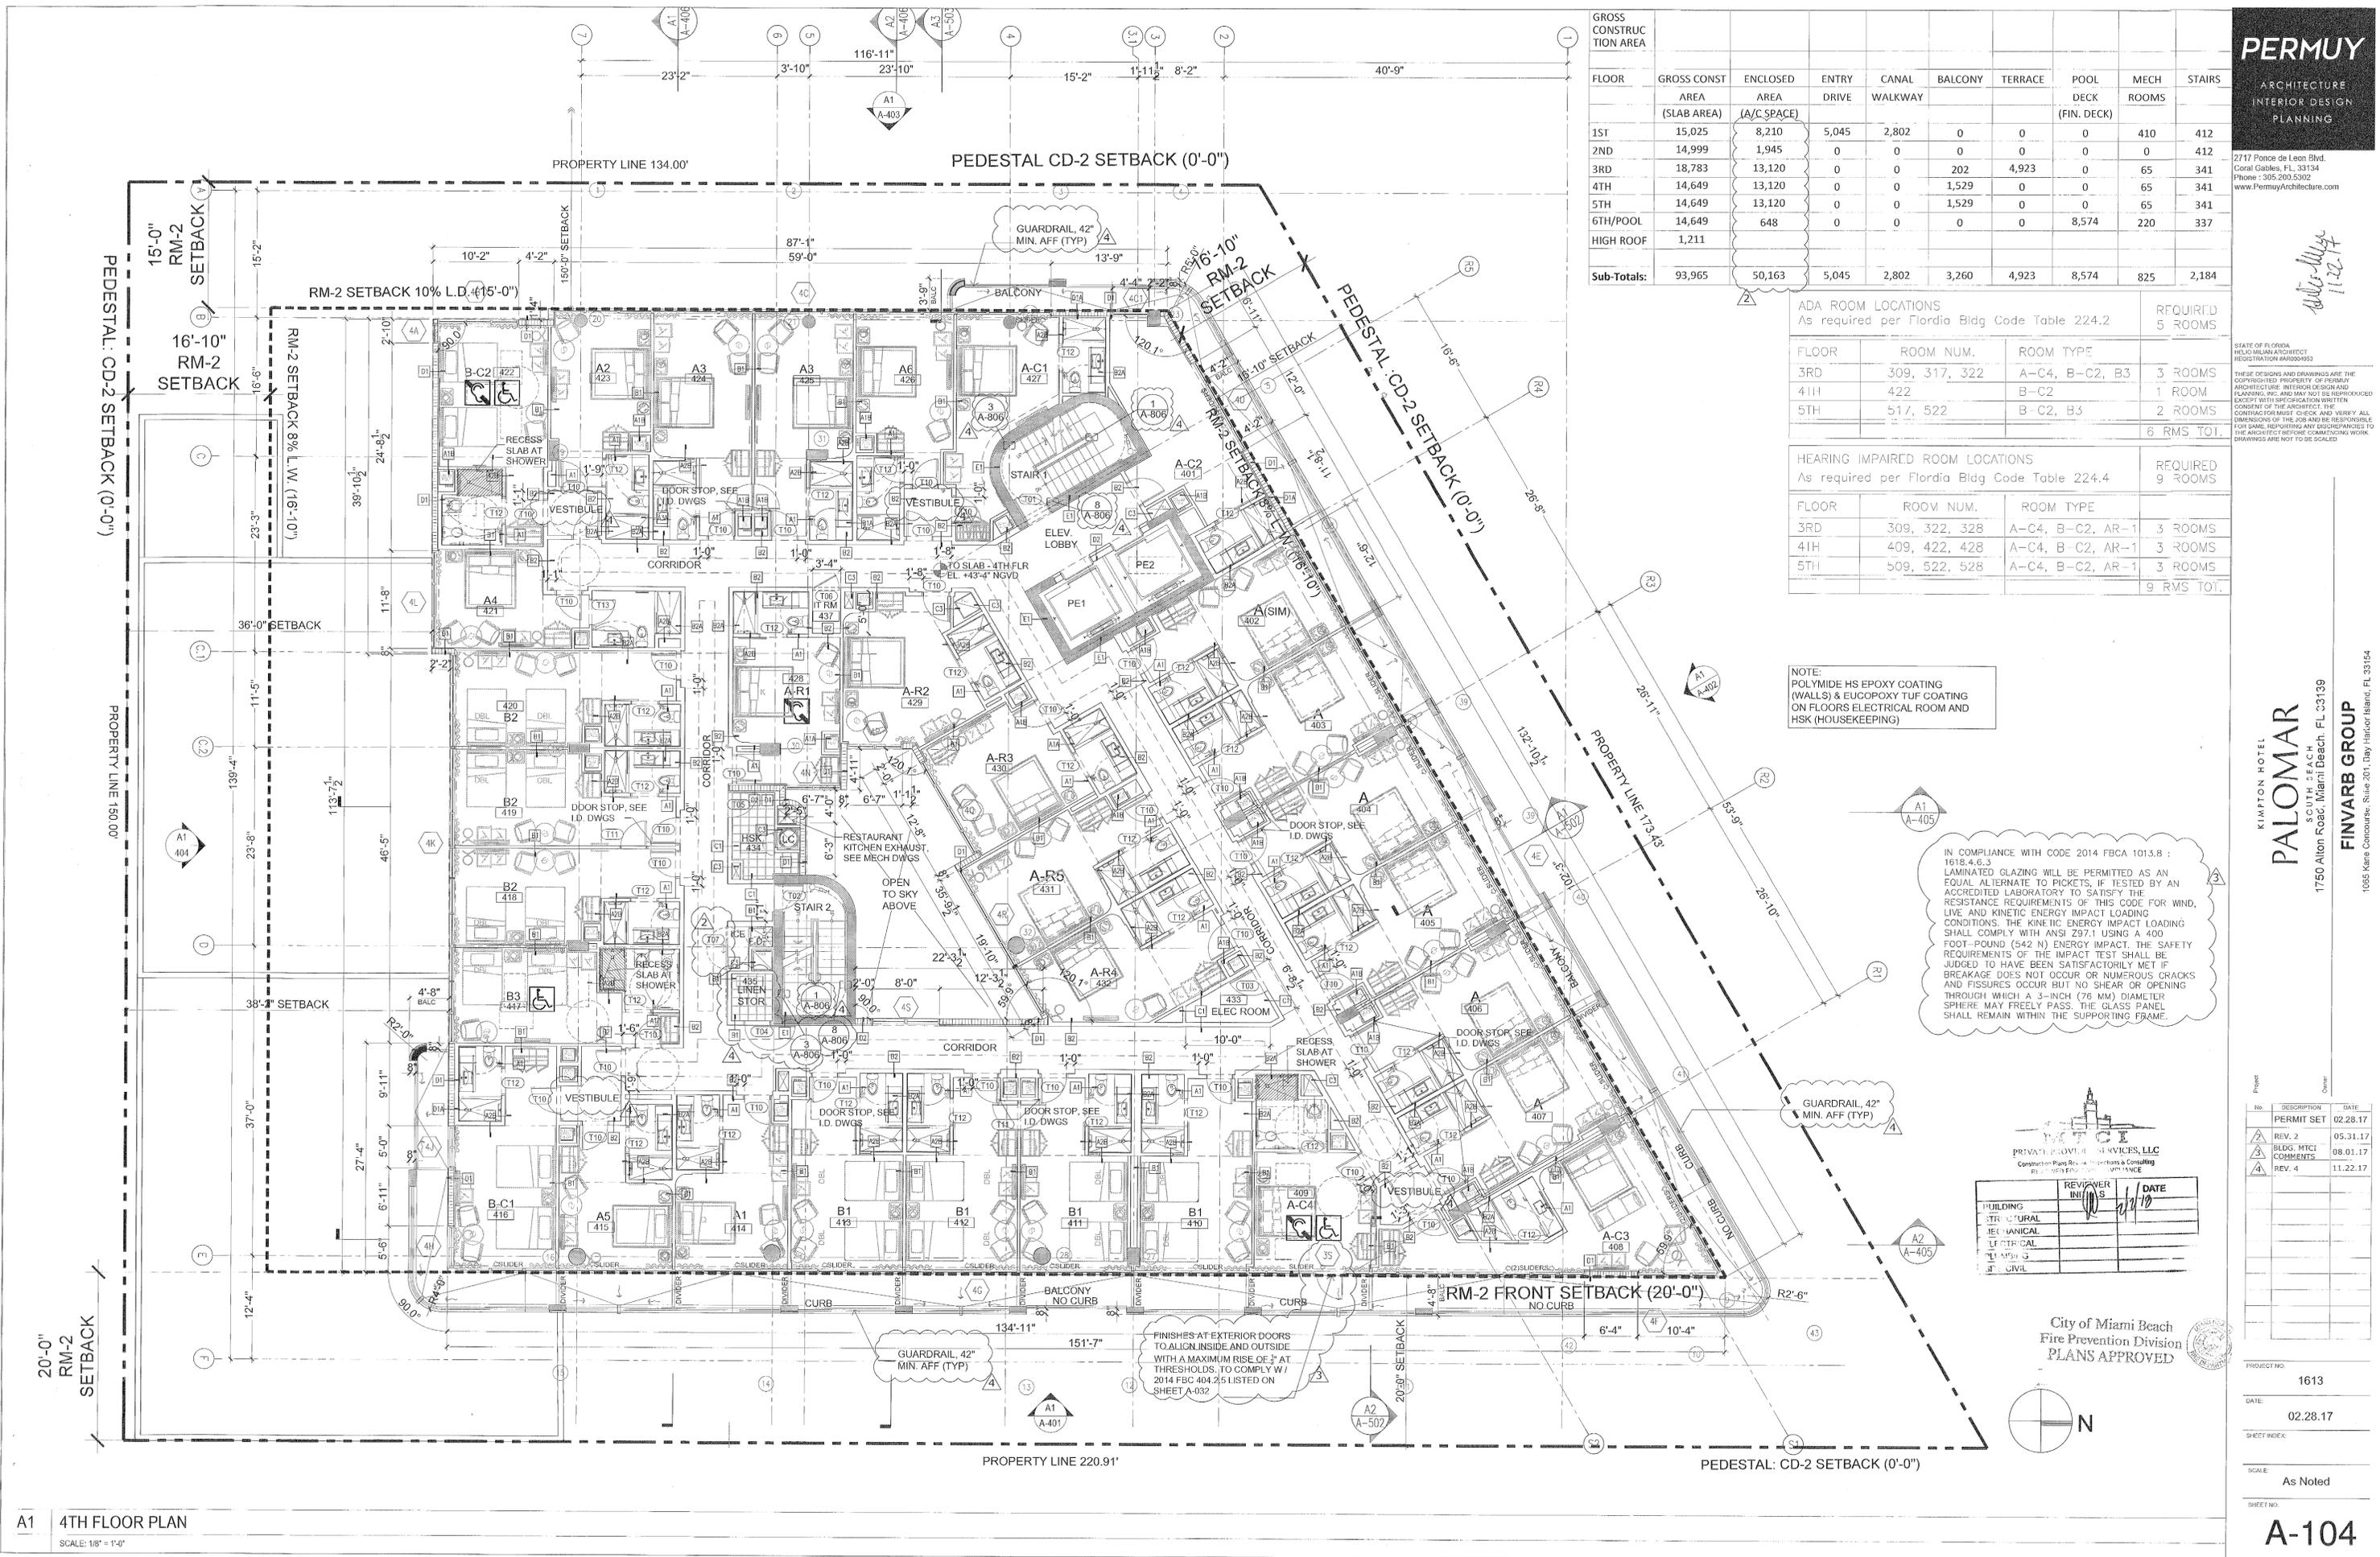

M. Permy
11-22-17

STATE OF FLORIDA
REGISTERED ARCHITECT
REGISTRATION #A00009653

THESE DESIGNS AND DRAWINGS ARE THE
COPYRIGHTED PROPERTY OF PERMUY
ARCHITECTURE, INTERIOR DESIGN AND
PLANNING, INC. AND MAY NOT BE REPRODUCED
WITHOUT THE WRITTEN CONSENT OF THE ARCHITECT. THE
CONTRACTOR MUST CHECK AND VERIFY ALL
DIMENSIONS OF THE JOB AND BE RESPONSIBLE
FOR SAME. REPORTING ANY DISCREPANCIES TO
THE ARCHITECT BEFORE COMMENCING WORK.
DRAWINGS ARE NOT TO BE SCALED.

HEARING IMPAIRED ROOM LOCATIONS
As required per Florida Bldg Code Table 224.4

FLOOR	ROOM NUM.	ROOM TYPE	REQUIRED
3RD	309, 317, 322	A-C4, B-C2, B3	3 ROOMS
4TH	422	B-C2	1 ROOM
5TH	517, 522	B-C2, B3	2 ROOMS
			6 RMS TOT.

HEARING IMPAIRED ROOM LOCATIONS
As required per Florida Bldg Code Table 224.4

FLOOR	ROOM NUM.	ROOM TYPE	REQUIRED
3RD	309, 322, 328	A-C4, B-C2, AR-1	3 ROOMS
4TH	409, 422, 428	A-C4, B-C2, AR-1	3 ROOMS
5TH	509, 522, 528	A-C4, B-C2, AR-1	3 ROOMS
			9 RMS TOT.

NOTE: POLYIMIDE HS EPOXY COATING
(WALLS) & EUCOPOXY TUF COATING
ON FLOORS ELECTRICAL ROOM AND
HSK (HOUSEKEEPING)

IN COMPLIANCE WITH CODE 2014 FBCA 1013.8 :
1618.4.6.3
LAMINATED GLAZING WILL BE PERMITTED AS AN
EQUAL ALTERNATE TO PICKETS, IF TESTED BY AN
ACCREDITED LABORATORY TO SATISFY THE
RESISTANCE REQUIREMENTS OF THIS CODE FOR WIND,
LIVE AND KINETIC ENERGY IMPACT LOADING
CONDITIONS. THE KINETIC ENERGY IMPACT LOADING
SHALL COMPLY WITH ANSI Z97.1 USING A 400
FOOT-POUND (542 N) ENERGY IMPACT. THE SAFETY
REQUIREMENTS OF THE IMPACT TEST SHALL BE
JUDGED TO HAVE BEEN SATISFACTORILY MET IF
BREAKAGE DOES NOT OCCUR OR NUMEROUS CRACKS
AND FISSURES OCCUR BUT NO SHEAR OR OPENING
THROUGH WHICH A 3-INCH (76 MM) DIAMETER
SPHERE MAY FREELY PASS. THE GLASS PANEL
SHALL REMAIN WITHIN THE SUPPORTING FRAME.

REVIEWER INITIALS

DATE

REVIEWED FOR CODE COMPLIANCE

BUILDING

STRUCTURAL

MECHANICAL


ELECTRICAL

PLUMBING

THE CIVIL

City of Miami Beach
Fire Prevention Division
PLANS APPROVED

FLOOR	GROSS CONSTRUCTION AREA								
	GROSS CONST AREA (SLAB AREA)	ENCLOSED AREA (A/C SPACE)	ENTRY DRIVE	CANAL WALKWAY	BALCONY	TERRACE	POOL DECK (FIN. DECK)	MECH ROOMS	STAIRS
1ST	15,025	8,210	5,045	2,802	0	0	0	410	412
2ND	14,999	1,945	0	0	0	0	0	0	412
3RD	18,783	13,120	0	0	202	4,923	0	65	341
4TH	14,649	13,120	0	0	1,529	0	0	65	341
5TH	14,649	13,120	0	0	1,529	0	0	65	341
6TH/POOL	14,649	648	0	0	0	0	8,574	220	337
HIGH ROOF	1,211								
Sub-Totals:	93,965	50,163	5,045	2,802	3,260	4,923	8,574	825	2,184

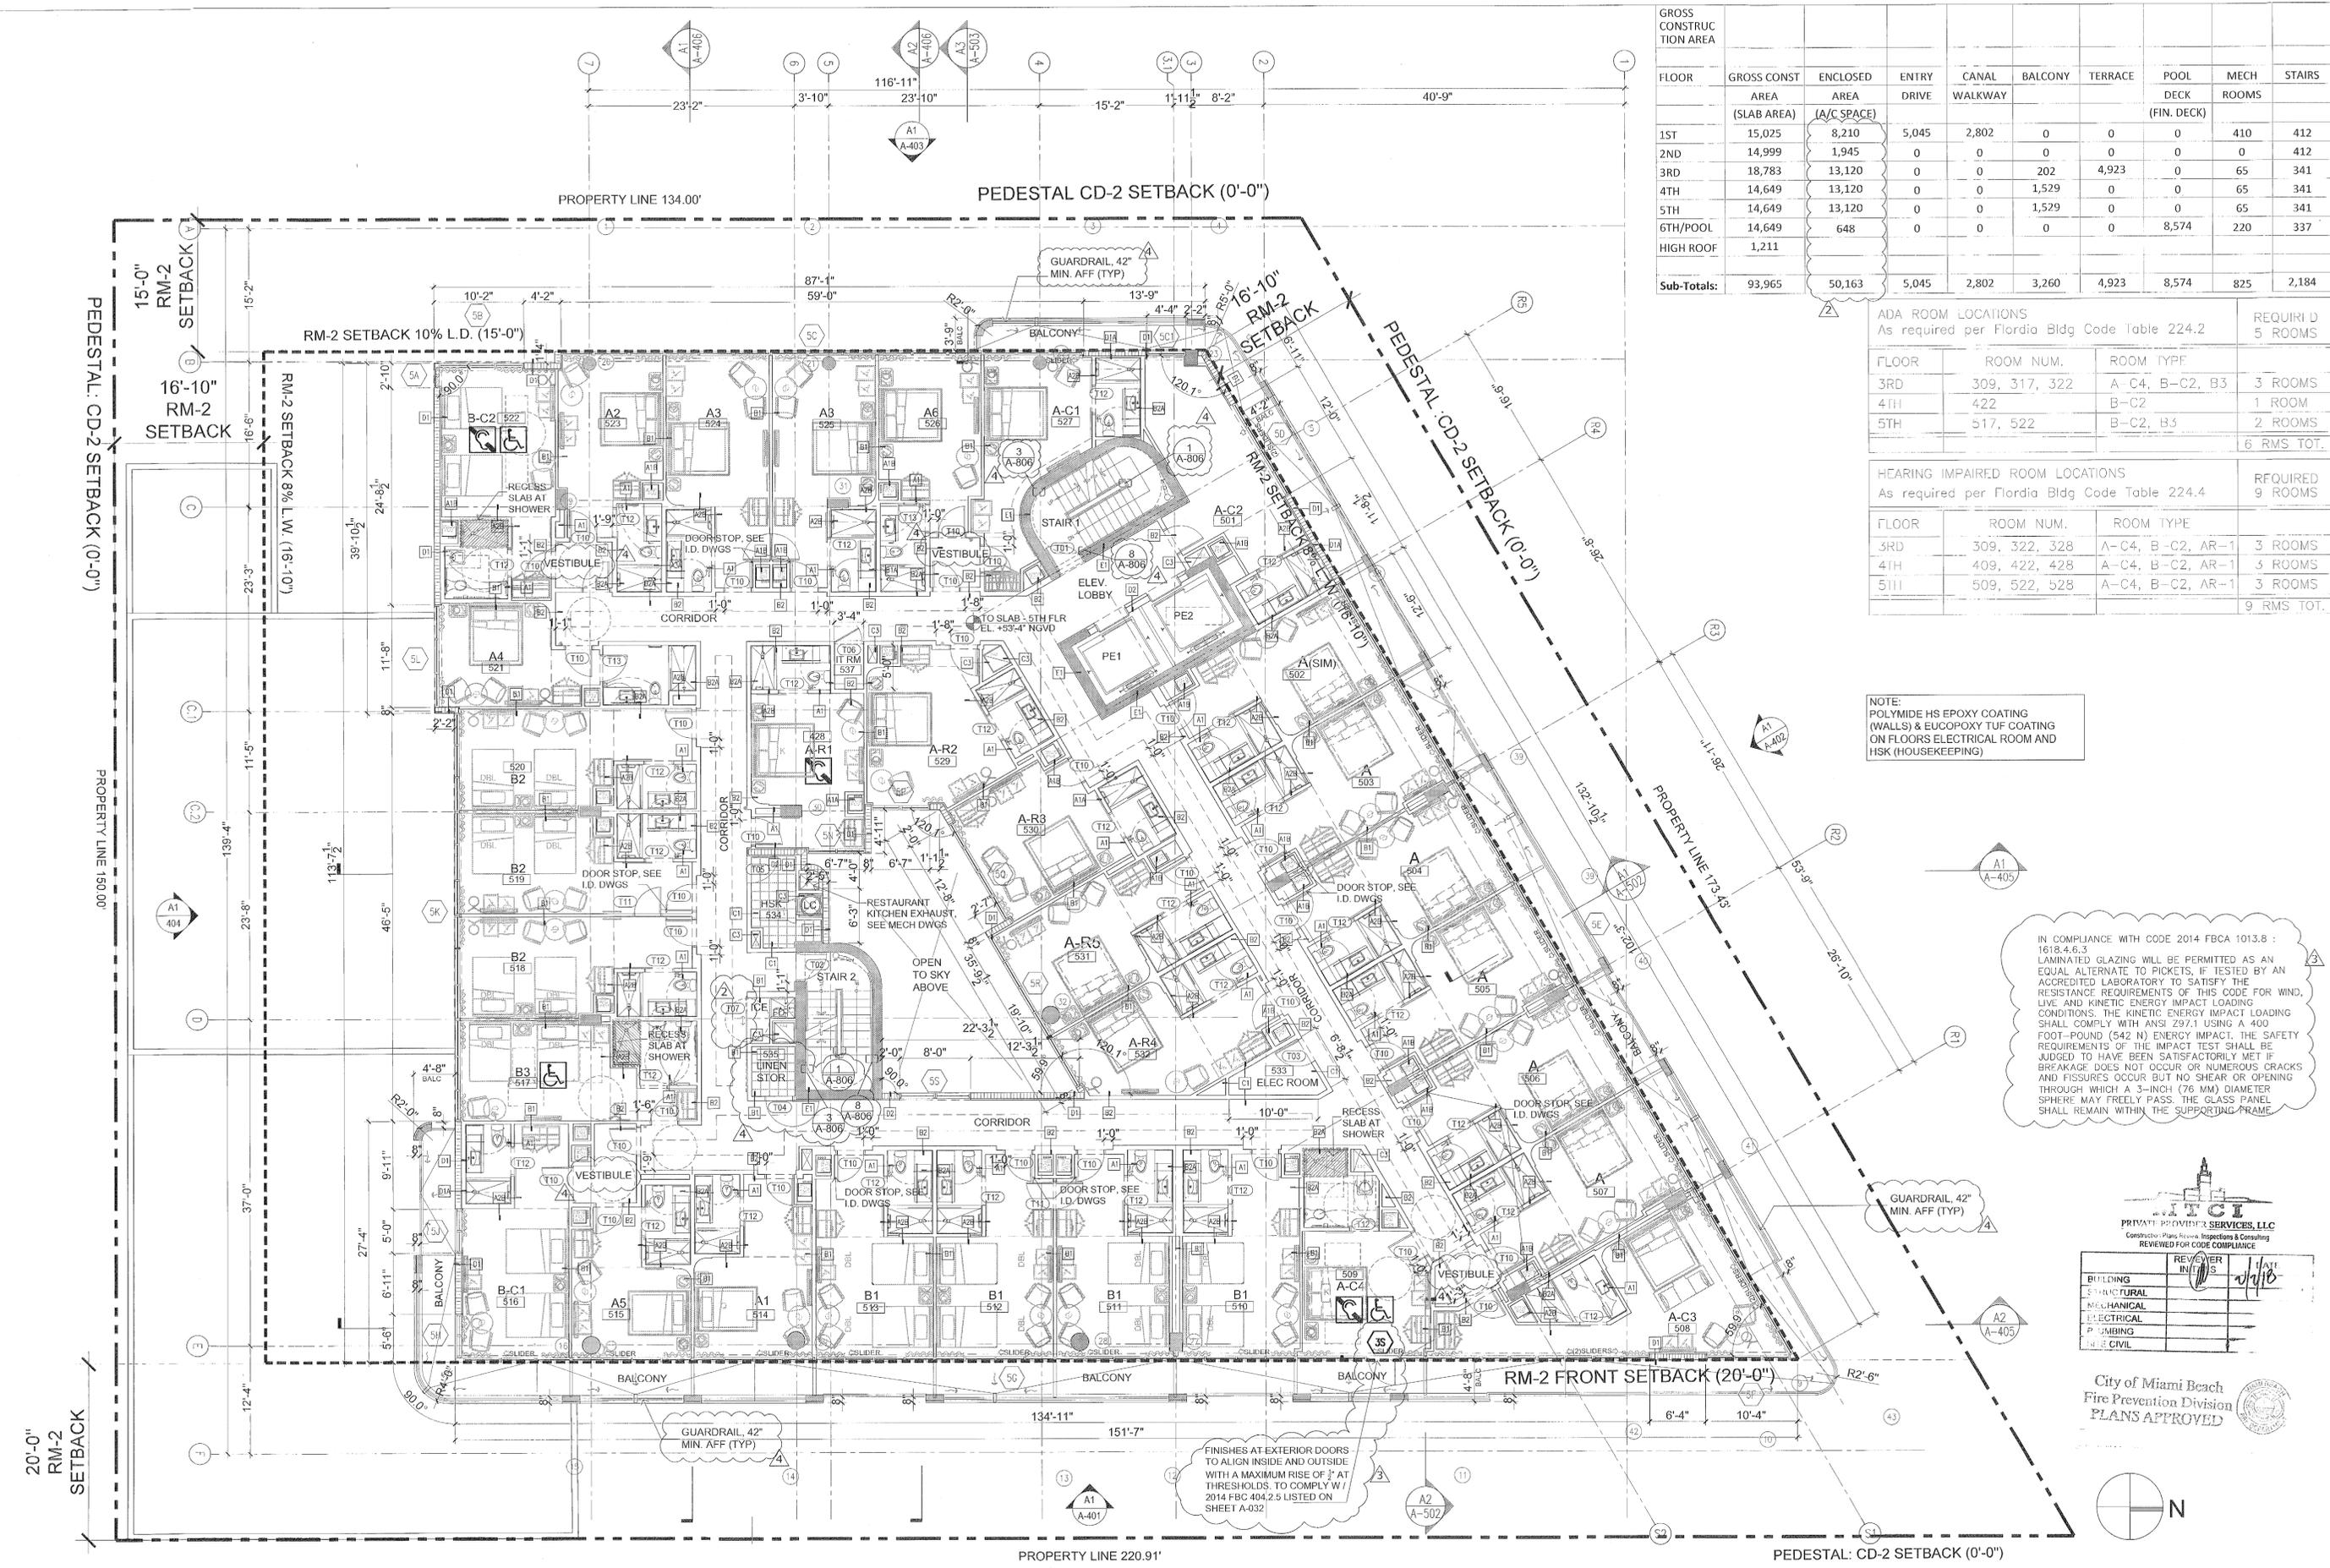

A1 5TH FLOOR PLAN
SCALE: 1/8" = 1'-0"

KIMPTON HOTEL
PALOMAR
1750 Alton Road, Miami Beach, FL 33139
FINVARR GROUP
1085 Kane Concourse, Suite 201, Haverhill Island, FL 33154


No.	DESCRIPTION	DATE
1	PERMIT SET	02.28.17
2	REV. 2 BLDG. MTCT COMMENTS	05.31.17
3	REV. 3	08.01.17
4	REV. 4	11.22.17

PROJECT NO. 1613
DATE: 02.28.17
SHEET INDEX:
SCALE: As Noted
SHEET NO. A-105


GENERAL NOTE:

1. COOLING TOWER EMERGENCY GENERATOR ROOM, BOILER ROOM, POOL, EQUIPMENT ROOM & STORAGE ROOM HAVE NO ROOF STRUCTURE & ARE OPEN TO SKY.
2. ALL TRASH CONTAINERS SHALL UTILIZE RUBBER WHEELS, OR THE PATH FOR THE TRASH CONTAINERS SHALL CONSIST OF A SURFACE FINISH THAT REDUCES NOISE, IN A MANNER TO BE REVIEWED AND APPROVED BY STAFF.
3. SIGN TO READ: THE POOL DECK SHALL BE CLOSED TO BETWEEN THE HOURS OF MIDNIGHT AND AM.
4. EXCEPT AS MAY BE REQUIRED FOR SECURITY, FIRE OR BUILDING CODE/ LIFE SAFETY CODE PURPOSES, NO SPEAKERS SHALL BE AFFIXED TO OR OTHERWISE LOCATED ON THE EXTERIOR OF THE BUILDING SHALL BE PLACED VOLUME AT A VOLUME THAT IS PLAINLY AUDIBLE FROM OTHER PROPERTIES AND WHICH INTERFERES WITH NORMAL CONVERSATION.
5. ALL HANDRAILS TO COMPLY WITH NFPA 5TH EDITION SECTION 7.2.2.4.4.9
6. USE OF THE ROOFTOP POOL DECK SHALL BE LIMITED TO THE EXCLUSIVE USE OF HOTEL GUESTS AND THEIR INVITEES.

- LIGHTING NOTE:**
1. ALL ROOFTOP LIGHTING SHALL CONSIST OF A LIGHTING FIXTURE THAT IS AFFIXED TO AND NO HIGHER THAN THE ROOFTOP PARAPET WALL.
 2. All roof top lighting fixtures shall be designed to preclude light spilling over to adjacent properties, in a manner to be reviewed and approved by staff—consistent with the Design Review Criteria and/or the directions from the Board.

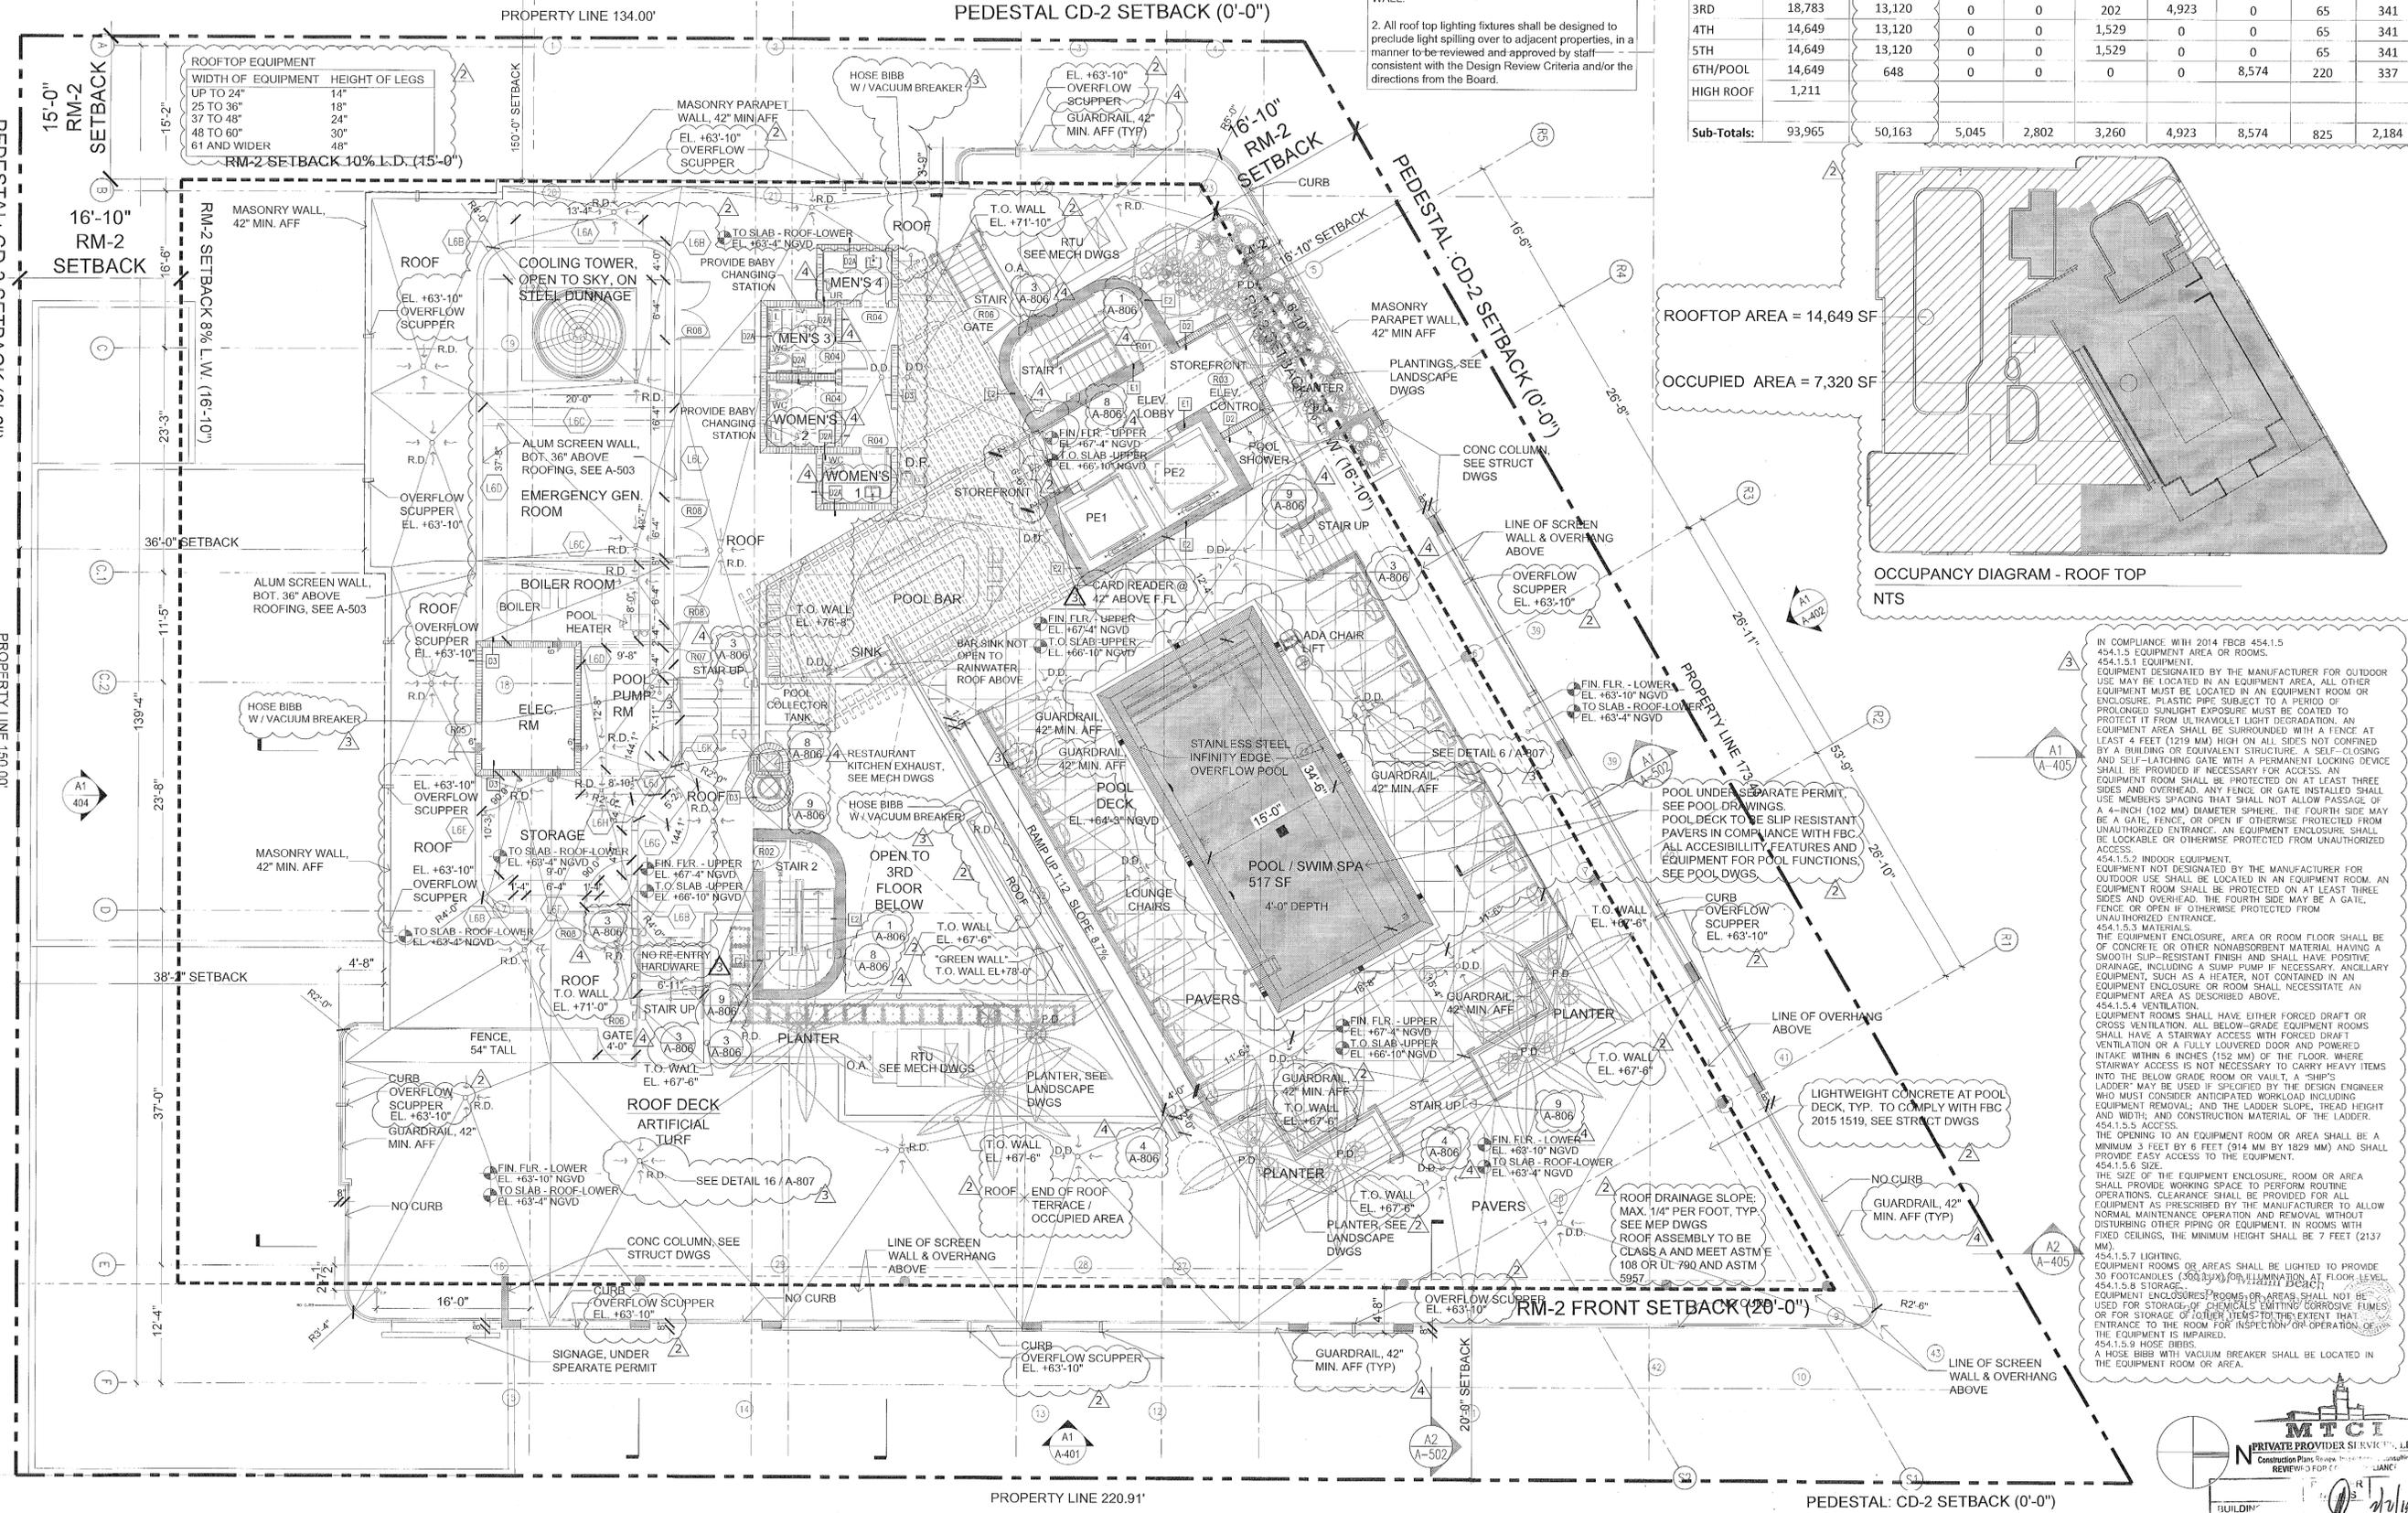

FLOOR	GROSS CONST AREA (SLAB AREA)	ENCLOSED AREA (A/C SPACE)	ENTRY DRIVE	CANAL WALKWAY	BALCONY	TERRACE	POOL DECK (FIN. DECK)	MECH ROOMS	STAIRS
1ST	15,025	8,210	5,045	2,802	0	0	0	410	412
2ND	14,999	1,945	0	0	0	0	0	0	412
3RD	18,783	13,120	0	0	202	4,923	0	65	341
4TH	14,649	13,120	0	0	1,529	0	0	65	341
5TH	14,649	13,120	0	0	1,529	0	0	65	341
6TH/POOL	14,649	648	0	0	0	0	8,574	220	337
High Roof	1,211								
Sub-Totals:	93,965	50,163	5,045	2,802	3,260	4,923	8,574	825	2,184

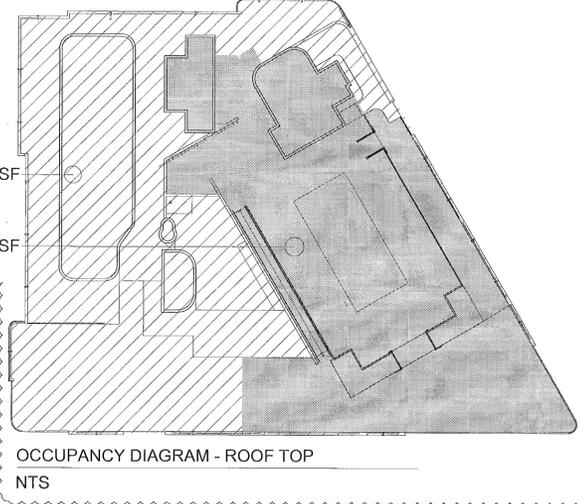

IN COMPLIANCE WITH 2014 FBC 454.1.5
 454.1.5.1 EQUIPMENT.
 EQUIPMENT DESIGNATED BY THE MANUFACTURER FOR OUTDOOR USE MAY BE LOCATED IN AN EQUIPMENT AREA OR ROOMS. ALL OTHER EQUIPMENT MUST BE LOCATED IN AN EQUIPMENT ROOM OR ENCLOSURE. PLASTIC PIPE SUBJECT TO A PERIOD OF PROLONGED SUNLIGHT EXPOSURE MUST BE COATED TO PROTECT IT FROM ULTRAVIOLET LIGHT DEGRADATION. AN EQUIPMENT AREA SHALL BE SURROUNDED WITH A FENCE AT LEAST 4 FEET (1219 MM) HIGH ON ALL SIDES NOT CONFINED BY A BUILDING OR EQUIPMENT STRUCTURE. A SELF-CLOSING AND SELF-LATCHING GATE WITH A PERMANENT LOCKING DEVICE SHALL BE PROVIDED IF NECESSARY FOR ACCESS. AN EQUIPMENT ROOM SHALL BE PROTECTED ON AT LEAST THREE SIDES AND OVERHEAD. ANY FENCE OR GATE INSTALLED SHALL BE A 4-INCH (102 MM) DIAMETER SPHERE. THE FOURTH SIDE MAY BE A GATE, FENCE, OR OPEN IF OTHERWISE PROTECTED FROM UNAUTHORIZED ENTRANCE. AN EQUIPMENT ENCLOSURE SHALL BE LOCKABLE OR OTHERWISE PROTECTED FROM UNAUTHORIZED ACCESS.
 454.1.5.2 INDOOR EQUIPMENT.
 EQUIPMENT NOT DESIGNATED BY THE MANUFACTURER FOR OUTDOOR USE SHALL BE LOCATED IN AN EQUIPMENT ROOM. AN EQUIPMENT ROOM SHALL BE PROTECTED ON AT LEAST THREE SIDES AND OVERHEAD. THE FOURTH SIDE MAY BE A GATE, FENCE, OR OPEN IF OTHERWISE PROTECTED FROM UNAUTHORIZED ENTRANCE.
 454.1.5.3 MATERIALS.
 THE EQUIPMENT ENCLOSURE, AREA OR ROOM FLOOR SHALL BE OF CONCRETE OR OTHER NONABSORBENT MATERIAL HAVING SMOOTH SLIP-RESISTANT FINISH AND SHALL HAVE POSITIVE DRAINAGE, INCLUDING A SUMP PUMP IF NECESSARY. ANCILLARY EQUIPMENT, SUCH AS A HEATER, NOT CONTAINED IN AN EQUIPMENT ENCLOSURE OR ROOM SHALL NECESSITATE AN EQUIPMENT AREA AS DESCRIBED ABOVE.
 454.1.5.4 VENTILATION.
 EQUIPMENT ROOMS SHALL HAVE EITHER FORCED DRAFT OR CROSS VENTILATION. ALL BELOW-GRADE EQUIPMENT ROOMS SHALL HAVE A STAIRWAY ACCESS WITH FORCED DRAFT VENTILATION OR A FULLY LOUVERED DOOR AND POWERED INTAKE WITHIN 6 INCHES (152 MM) OF THE FLOOR, WHERE STAIRWAY ACCESS IS NOT NECESSARY TO CARRY HEAVY ITEMS INTO THE BELOW GRADE ROOM OR VAULT, A "SHIP'S LADDER" MAY BE USED IF SPECIFIED BY THE DESIGN ENGINEER WHO MUST CONSIDER ANTICIPATED WORKLOAD INCLUDING EQUIPMENT REMOVAL, AND THE LADDER SLOPE, TREAD HEIGHT AND WIDTH, AND CONSTRUCTION MATERIAL OF THE LADDER.
 454.1.5.5 ACCESS.
 THE OPENING TO AN EQUIPMENT ROOM OR AREA SHALL BE A MINIMUM 3 FEET BY 6 FEET (914 MM BY 1829 MM) AND SHALL PROVIDE EASY ACCESS TO THE EQUIPMENT.
 454.1.5.6 SIZE.
 THE SIZE OF THE EQUIPMENT ENCLOSURE, ROOM OR AREA SHALL PROVIDE WORKING SPACE TO PERFORM ROUTINE OPERATIONS. CLEARANCE SHALL BE PROVIDED FOR ALL EQUIPMENT AS PRESCRIBED BY THE MANUFACTURER TO ALLOW NORMAL MAINTENANCE OPERATION AND REMOVAL WITHOUT DISTURBING OTHER PIPING OR EQUIPMENT. IN ROOMS WITH FIXED CEILINGS, THE MINIMUM HEIGHT SHALL BE 7 FEET (2137 MM).
 454.1.5.7 LIGHTING.
 EQUIPMENT ROOMS OR AREAS SHALL BE LIGHTED TO PROVIDE 30 FOOT-CANDLES (300 LUX) OF ILLUMINATION AT FLOOR LEVEL.
 454.1.5.8 STORAGE.
 EQUIPMENT ENCLOSURES, ROOMS OR AREAS SHALL NOT BE USED FOR STORAGE OF CHEMICALS EMITTING CORROSIVE FUMES OR FOR STORAGE OF OTHER ITEMS TO THE EXTENT THAT ENTRANCE TO THE ROOM FOR INSPECTION OR OPERATION OF THE EQUIPMENT IS IMPAIRED.
 454.1.5.9 HOSE BIBBS.
 A HOSE BIBB WITH VACUUM BREAKER SHALL BE LOCATED IN THE EQUIPMENT ROOM OR AREA.

2717 Ponce de Leon Blvd.
 Coral Gables, FL 33134
 Phone: 305.200.5302
 www.PermuyArchitecture.com

STATE OF FLORIDA
 REAL ESTATE ARCHITECT
 REGISTRATION #45004953

THESE DESIGNS AND DRAWINGS ARE THE
 COPYRIGHTED PROPERTY OF PERMUY
 ARCHITECTURE INTERIOR DESIGN AND
 PLANNING, INC. AND MAY NOT BE REPRODUCED
 OR TRANSMITTED IN ANY FORM OR BY ANY
 MEANS, ELECTRONIC OR MECHANICAL,
 INCLUDING PHOTOCOPYING, RECORDING,
 OR BY ANY INFORMATION STORAGE AND
 RETRIEVAL SYSTEM, WITHOUT THE WRITTEN
 CONSENT OF THE ARCHITECT. THE
 CONTRACTOR MUST CHECK AND VERIFY ALL
 DIMENSIONS OF THE JOB AND BE RESPONSIBLE
 FOR SAME. REPORT ANY DISCREPANCIES TO
 THE ARCHITECT BEFORE COMMENCING WORK.
 DRAWINGS ARE NOT TO BE SCALED

PALOMAR
 KIMPTON HOTEL
 SOUTH BEACH
 1750 Alton Road, Miami Beach, FL 33139
FINVARB GROUP
 1085 Kane Concourse, Suite 201, Bay Harbor Island, FL 33154

No.	DESCRIPTION	DATE
1	PERMIT SET	02.28.17
2	REV. 2	05.31.17
3	BLDG. MEI COMMENTS	08.01.17
4	REV. 4	11.23.17

PROJECT NO. 1613
 DATE: 02.28.17
 SHEET INDEX:
 As Noted




M. De-Valley
11-22-17

STATE OF FLORIDA
REGISTERED ARCHITECT
REGISTRATION #A00000655

THESE DESIGNS AND DRAWINGS ARE THE
EXCLUSIVE PROPERTY OF PERMUY
ARCHITECTURE INTERIOR DESIGN AND
PLANNING, INC. AND MAY NOT BE REPRODUCED
EXCEPT WITH SPECIFICATION WRITTEN
CONSENT OF THE ARCHITECT. THE
CONTRACTOR MUST CHECK AND VERIFY ALL
DIMENSIONS OF THE JOB AND BE RESPONSIBLE
FOR SAME. REPORTING ANY DISCREPANCIES TO
THE ARCHITECT BEFORE COMMENCING WORK.
DRAWINGS ARE NOT TO BE SCALED.

FLOOR	GROSS CONSTRUCTION AREA								
	GROSS CONST AREA (SLAB AREA)	ENCLOSED AREA (A/C SPACE)	ENTRY DRIVE	CANAL WALKWAY	BALCONY	TERRACE	POOL DECK (FIN. DECK)	MECH ROOMS	STAIRS
1ST	15,025	8,210	5,045	2,802	0	0	0	410	412
2ND	14,999	1,945	0	0	0	0	0	0	412
3RD	18,783	13,120	0	0	202	4,923	0	65	341
4TH	14,649	13,120	0	0	1,529	0	0	65	341
5TH	14,649	13,120	0	0	1,529	0	0	65	341
6TH/POOL	14,649	648	0	0	0	0	8,574	220	337
HIGH ROOF	1,211								
Sub-Totals:	93,965	50,163	5,045	2,802	3,260	4,923	8,574	825	2,184

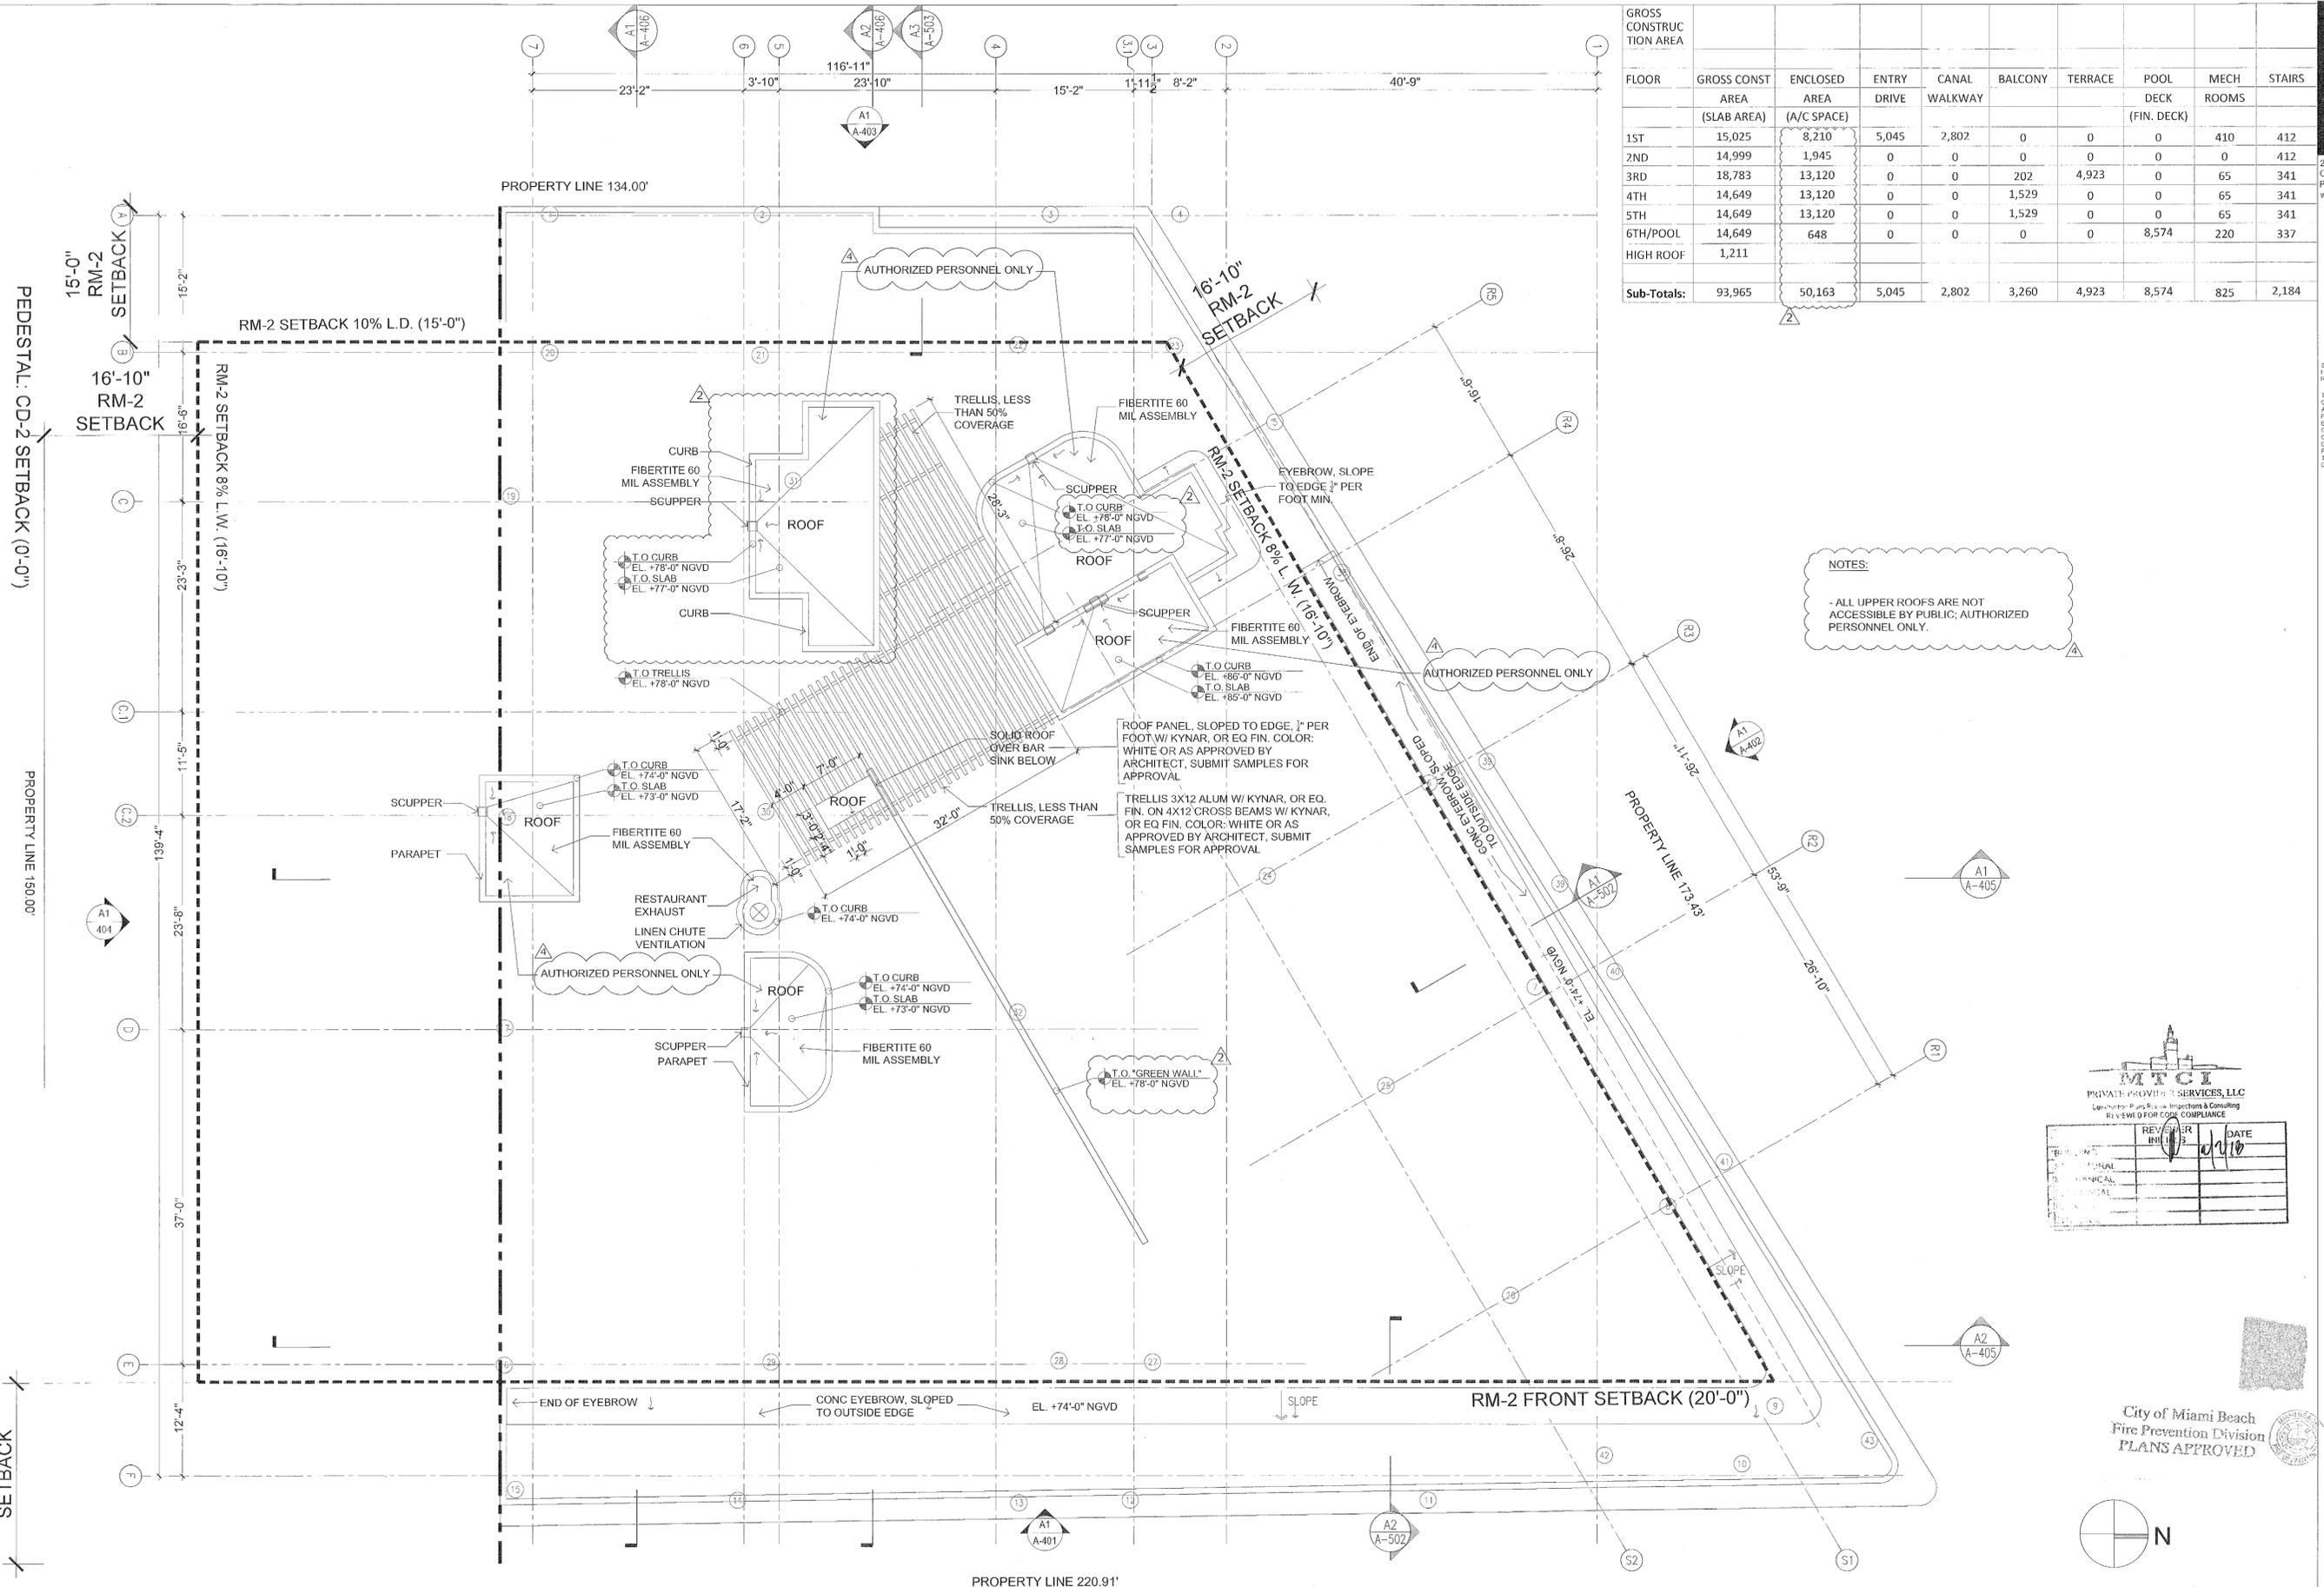


NOTES:
- ALL UPPER ROOFS ARE NOT ACCESSIBLE BY PUBLIC; AUTHORIZED PERSONNEL ONLY.

MTCI
PRIVATE PROVIDER SERVICES, LLC
Construction Plans Review Inspections & Consulting
REVIEWED FOR CODE COMPLIANCE

REVISION	DATE
1	02/28/17
2	05/31/17
4	11/22/17





City of Miami Beach
Fire Prevention Division
PLANS APPROVED

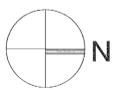

No.	DESCRIPTION	DATE
PERMIT SET		02.28.17
REV. 2		05.31.17
REV. 4		11.22.17

PROJECT NO: 1613
DATE: 02.28.17
SHEET INDEX:
SCALE: As Noted
SHEET NO.

GENERAL NOTES:
 1 - THE FIRE RESISTIVE RATING OF CEILING ASSEMBLIES SHALL NOT BE LESS THAN THAT REQUIRED BY HTE BLDG TYPE CONSTRUCTION.
 2 - CEILING PANELS - THEY SHALL RESIST AN UPWARD FORCE OF 1 LB. PER S.F.
 3 - ACCESS DOORS - SHALL MEET ASTM E 119 OR UL 263 AS HORIZONTAL ASSEMBLIES AND LABELED BY AN APPROVED AGENCY FOR SUCH PURPOSE.

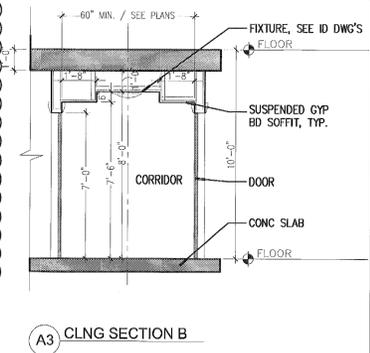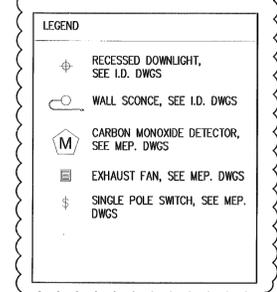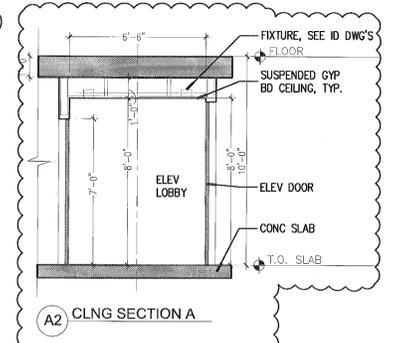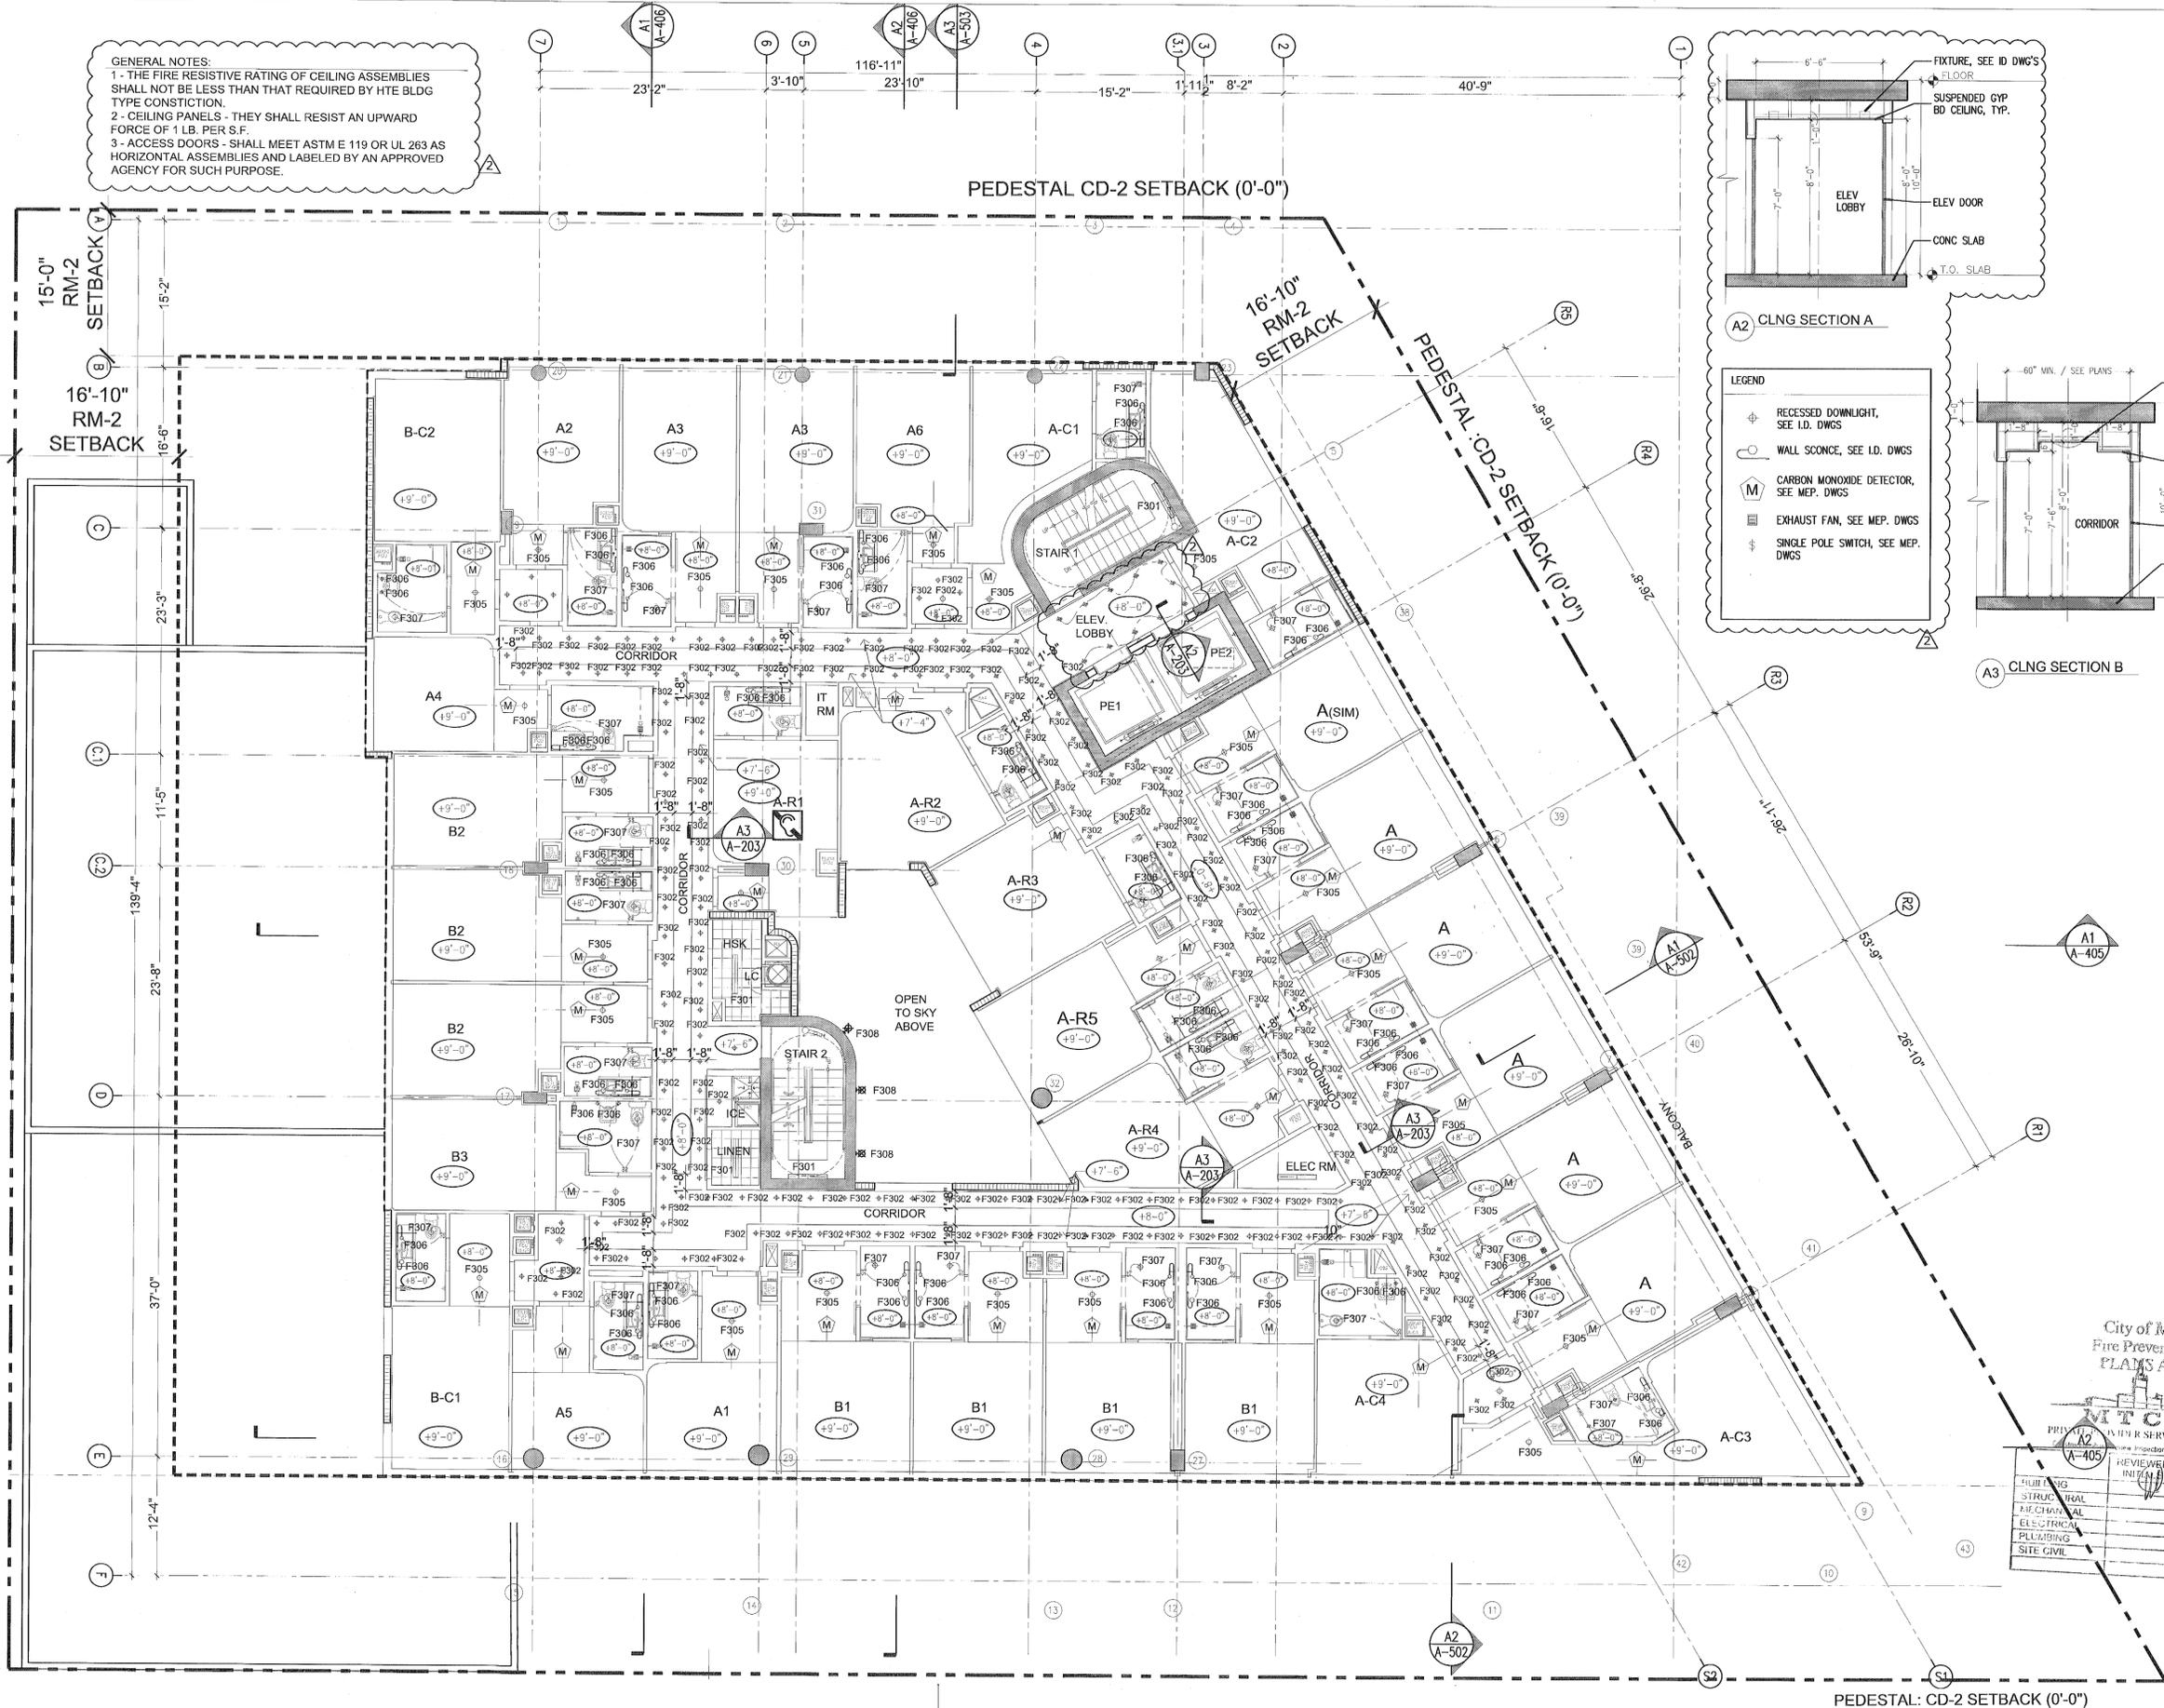

PERMUY
 ARCHITECTURE
 INTERIOR DESIGN
 PLANNING
 2717 Ponce de Leon Blvd.
 Coral Gables, FL 33134
 Phone : 305.200.5302
 www.PermuyArchitecture.com

Helena M. ...
 5/31/17

STATE OF FLORIDA
 FIELD BUILDING ARCHITECT
 REGISTRATION #00054963
 THESE DESIGNS AND DRAWINGS ARE THE COPYRIGHTED PROPERTY OF PERMUY ARCHITECTURE INTERIOR DESIGN AND PLANNING, INC. AND MAY NOT BE REPRODUCED EXCEPT WITH SPECIFICATION WRITTEN CONSENT OF THE ARCHITECT. THE CONTRACTOR MUST CHECK AND VERIFY ALL DIMENSIONS OF THE JOB AND BE RESPONSIBLE FOR SAME. REPORTING ANY DISCREPANCIES TO THE ARCHITECT BEFORE COMMENCING WORK. DRAWINGS ARE NOT TO BE SCALED.


KLAMPTON HOTEL
PALOMAR
 SOUTH BEACH
 1750 Alton Road, Miami Beach, FL 33139
FINVARB GROUP
 1005 Kane Concourse, Suite 2011, Bay Harbor Island, FL 33154

City of Miami Beach
 Fire Prevention Division
PLANS APPROVED

PROJECT NO.	1613
DATE	02.28.17
SHEET INDEX	
SCALE	As Noted
SHEET NO.	A-203

No.	DESCRIPTION	DATE
1	PERMIT SET	02.28.17
2	REV. 2	05.31.17

GENERAL NOTES:
1 - THE FIRE RESISTIVE RATING OF CEILING ASSEMBLIES SHALL NOT BE LESS THAN THAT REQUIRED BY HTE BLDG TYPE CONSTRUCTION.
2 - CEILING PANELS - THEY SHALL RESIST AN UPWARD FORCE OF 1 LB. PER S.F.
3 - ACCESS DOORS - SHALL MEET ASTM E 119 OR UL 263 AS HORIZONTAL ASSEMBLIES AND LABELED BY AN APPROVED AGENCY FOR SUCH PURPOSE.

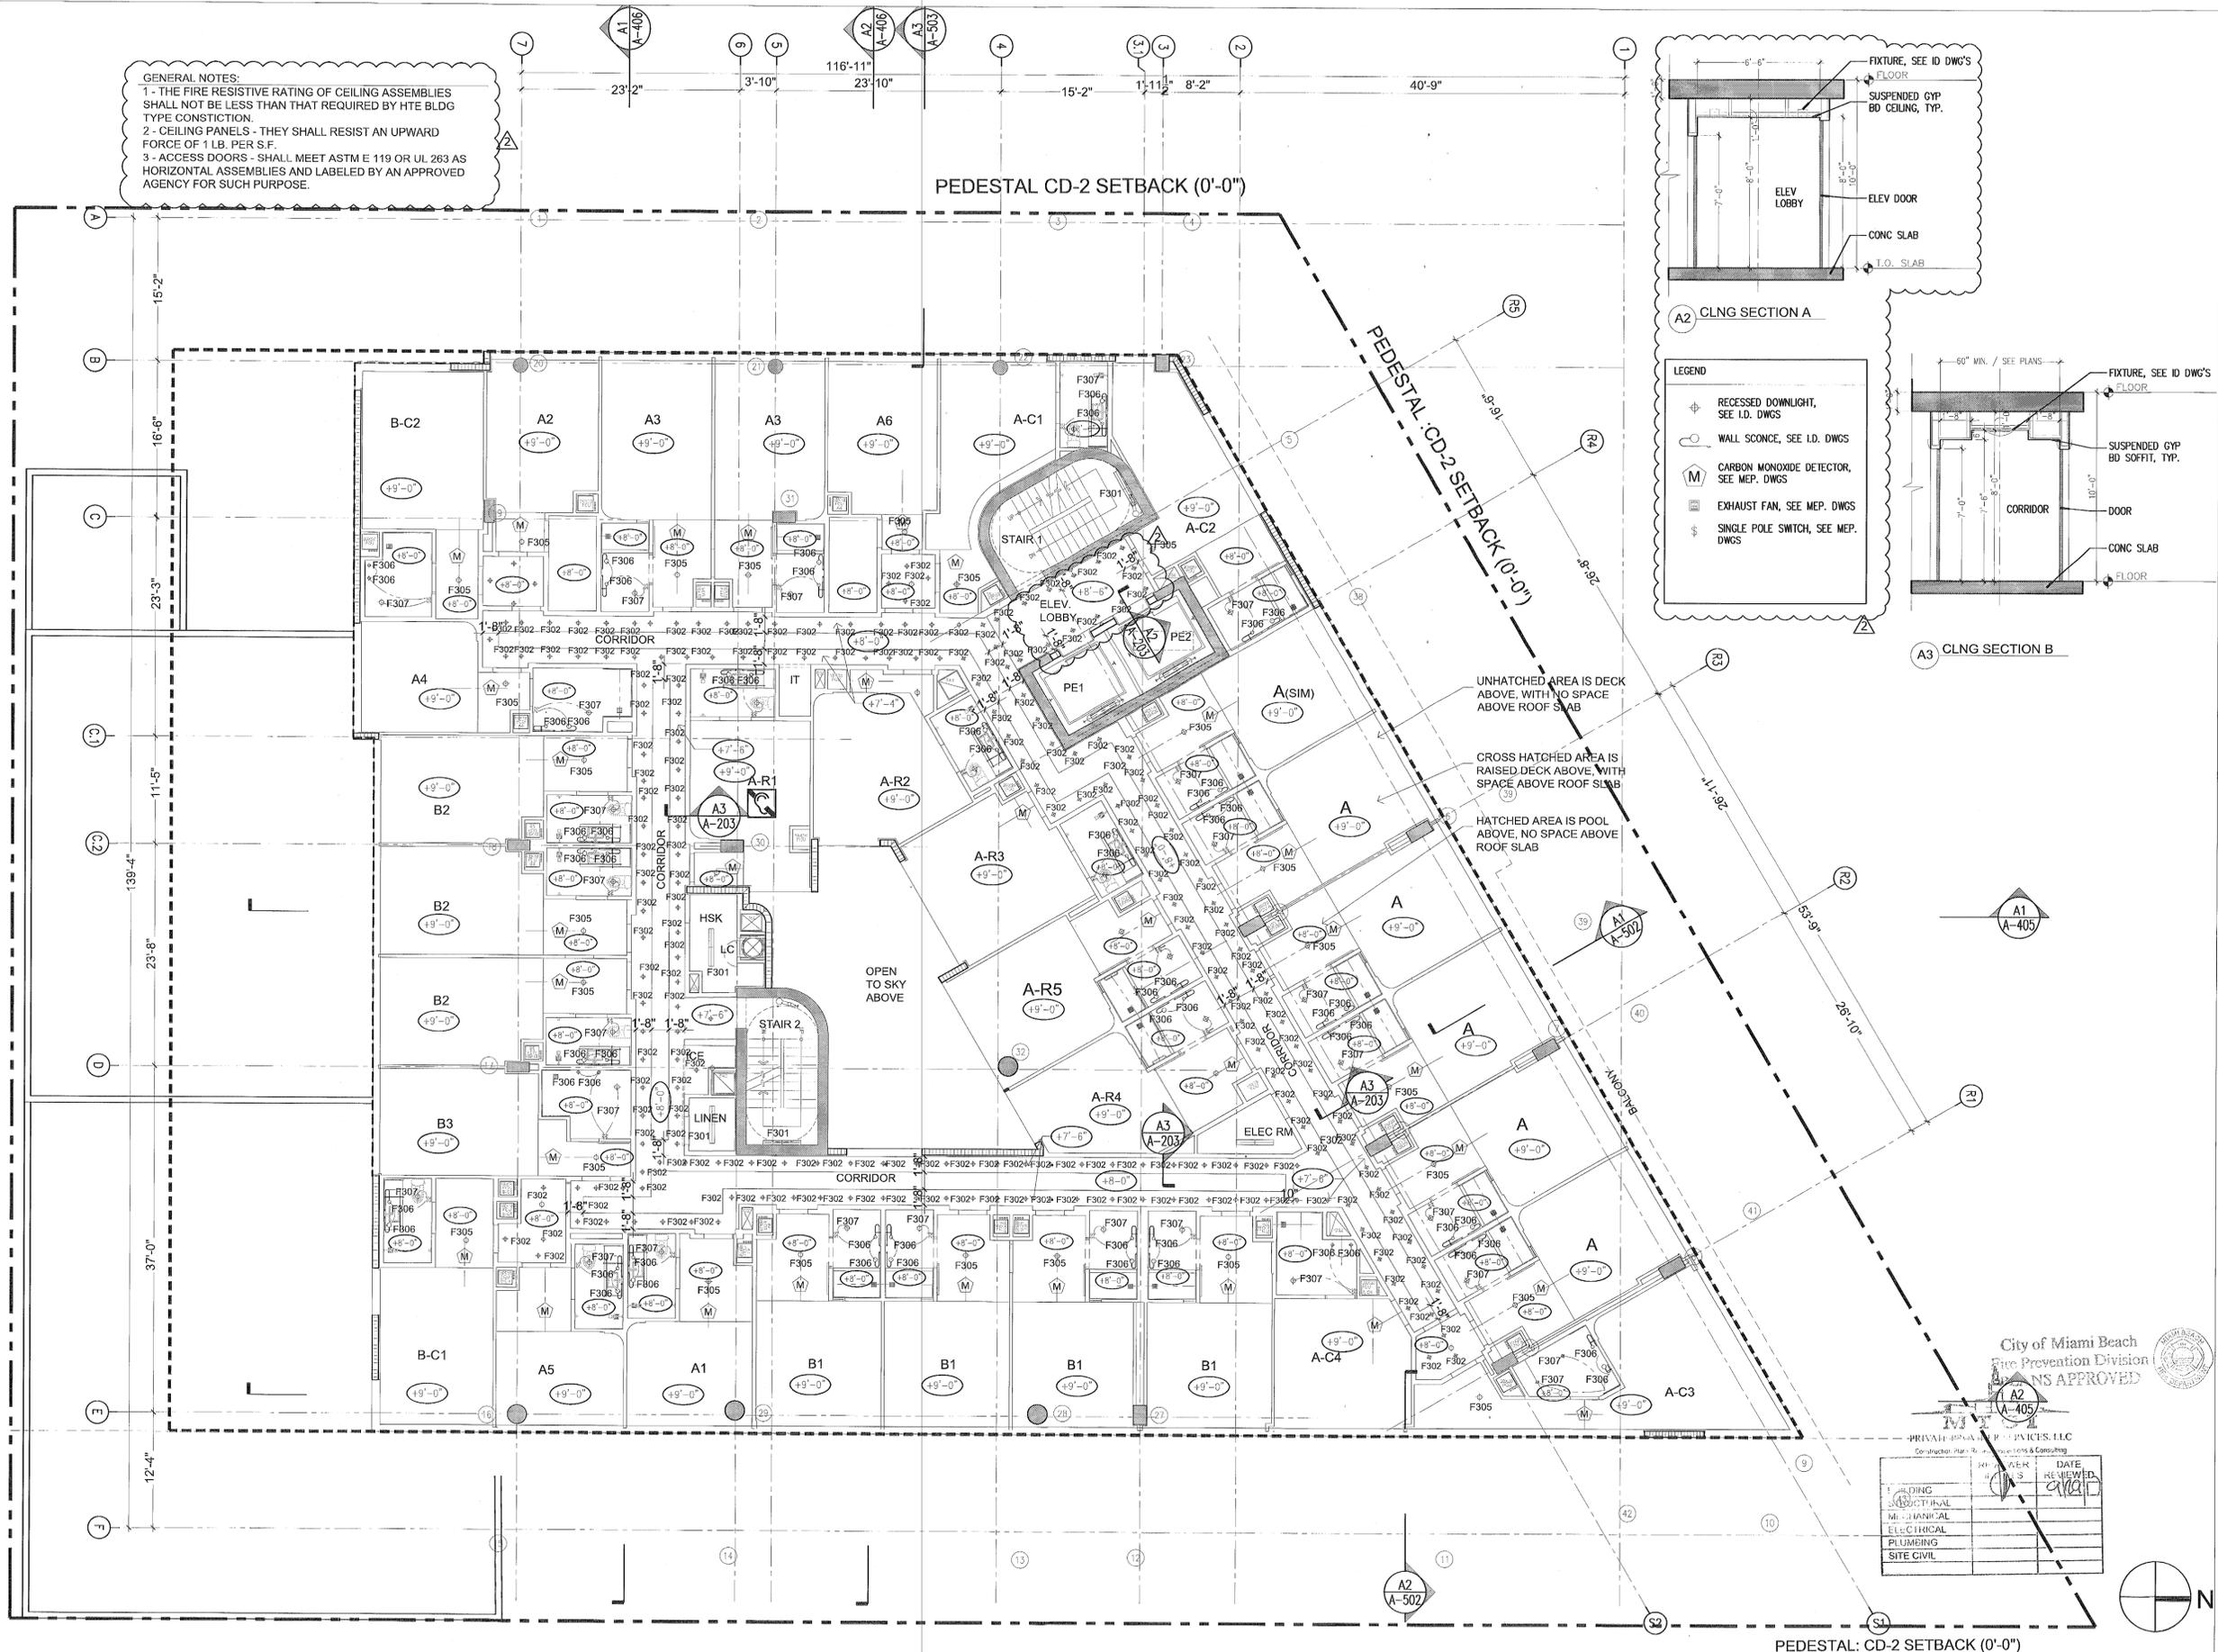

City of Miami Beach
Fire Prevention Division
APPROVED

PRIVAH DESIGN SERVICES, LLC
Construction Plans, Specifications and Consulting


NO.	DESCRIPTION	DATE
1	PERMIT SET	02.28.17
2	REV. 2	05.31.17

NO.	REVISION	DATE
1	ISSUED	02.28.17
2	REVISED	05.31.17

PROJECT NO: 1613
DATE: 02.28.17
SHEET NO: 1
SCALE: As Noted
SHEET NO: A-205

DOOR #	FROM	TO	TYPE	MATERIAL	SIZE			LABEL	FIRE RATING	MATERIAL	HEAD	JAMB	THRESHOLD	REMARKS
	ROOM NAME	ROOM NAME			PANEL WIDTH	HEIGHT	THICKNESS							
122	DESK	BAGGAGE RM	A	HM	3'-0"	7'-0"	1-3/4"	B	2 HOUR	HM				1
123	MDF CLOSET	BAGGAGE RM	M	WD	5'-4"	7'-0"	1-3/4"			WD				
124	MDF CLOSET	BAGGAGE RM	M	WD	5'-4"	7'-0"	1-3/4"			WD				
125	TOILET	WC CORRIDOR	A	WD	3'-0"	7'-0"	1-3/4"			WD				1

- NOTES:**
- ① - EXPOSED CONC SLAB, PAINT FINISH.
 - ② - SMOOTH 3" STUCCO, PAINT FINISH.
 - ③ - SMOOTH MONOCOTE, PAINT FINISH.
 - ④ - SUSPENDED 3/4" GYP. BD., PAINT FINISH.
 - ⑤ - FIRE SPRINKLER HEADS AND OTHER CEILING FEATURES (ACCESS DOORS, GRILLES, LIGHT FIXTURES, ETC.) ARE SHOWN ONLY FOR ALIGNMENT. FOR THEIR MECHANICAL CHARACTERISTICS (SIZES, QUANTITY, THRS, ETC.) REFER TO MECHANICAL AND ELECTRICAL DRAWINGS AND SPECIFICATIONS.
 - ⑥ - GENERAL CONTRACTOR TO SUBMIT SHOP DRAWINGS FOR REVIEW BEFORE INSTALLATION. E.G. TO COORDINATE LOCATIONS AND COORDINATE WITH ALL TRADES PRIOR TO SUBMITTAL.
 - ⑦ - FINISH CEILING HEIGHTS ARE GIVEN FROM TOP OF CONCRETE FLOOR SLAB (UNLESS OTHERWISE NOTED).
 - ⑧ - ALL STORM AND SANITARY PIPES - VERTICALLY AND HORIZONTALLY - SHALL BE INSULATED (MIN. 1") INCLUDING THE ONES WITHIN DROPPED CEILINGS.
 - ⑨ - ALL PERIMETER PARTITIONS AND ALL ABOVE DOOR HEADERS OPENING A PLENUM AREA, METAL STUDS AND INTERNAL DRYWALL LAYERS MUST EXTEND TO THE UNDERSIDE OF THE CONCRETE SLAB.
 - ⑩ - NO COMBUSTIBLE MATERIALS SHOULD BE ALLOWED IN THE A/C PLENUM AREAS AND A/C CLOSETS. HOWEVER, WHERE APPROVED LIMITED COMBUSTIBLE MATERIALS ARE TO BE USED IN A/C PLENUM AREAS AND A/C CLOSETS, THESE MATERIALS SHALL BE TREATED WITH PLENUM APPROVED PRODUCTS IN ORDER TO ACHIEVE COMPLIANCE WITH THE FLAME SPREAD RATING NOT GREATER THAN 25 AND THE SMOKE DEVELOPED RATING NOT GREATER THAN 50.
 - ⑪ - A/C PLENUM AREAS SHALL BE OF NON COMBUSTIBLE OR LIMITED COMBUSTIBLE MATERIALS, AND HAVE A FLAME SPREAD RATING NOT GREATER THAN 25 AND SMOKE DEVELOPED RATING NOT GREATER THAN 50.
- LEGEND**
- CEILING HEIGHTS INDICATED BY THIS SHADE ARE: LEVELS 3-5 - HOTEL 9'-0" A.C.S.
 - CEILING HEIGHTS INDICATED BY THIS SHADE ARE: LEVELS 3-5 - HOTEL 8'-0" A.C.S.
 - (UNLESS OTHERWISE NOTED) * A.C.S. = ABOVE CONCRETE SLAB
 - +8'-0" - OTHER CEILING HEIGHTS A.C.S.
 - R-19 MIN. INSULATION BOARD AT CEILING
 - RECESSED WALL MOUNTED LIGHT
 - RECESSED DOWNLIGHT
 - WALL MOUNTED LIGHT
 - JUNCTION BOX
 - WALL MOUNTED "J" BOX
 - A/C SUPPLY (CEILING MOUNTED)
 - A/C SUPPLY (WALL MOUNTED)
 - A/C RETURN (WALL MOUNTED)
 - A/C RETURN GRILLE
 - SOFFIT LINE
 - HEADER
 - PLENUM AREA
 - 1 HR. RATED WALL
 - 2 HR. RATED WALL

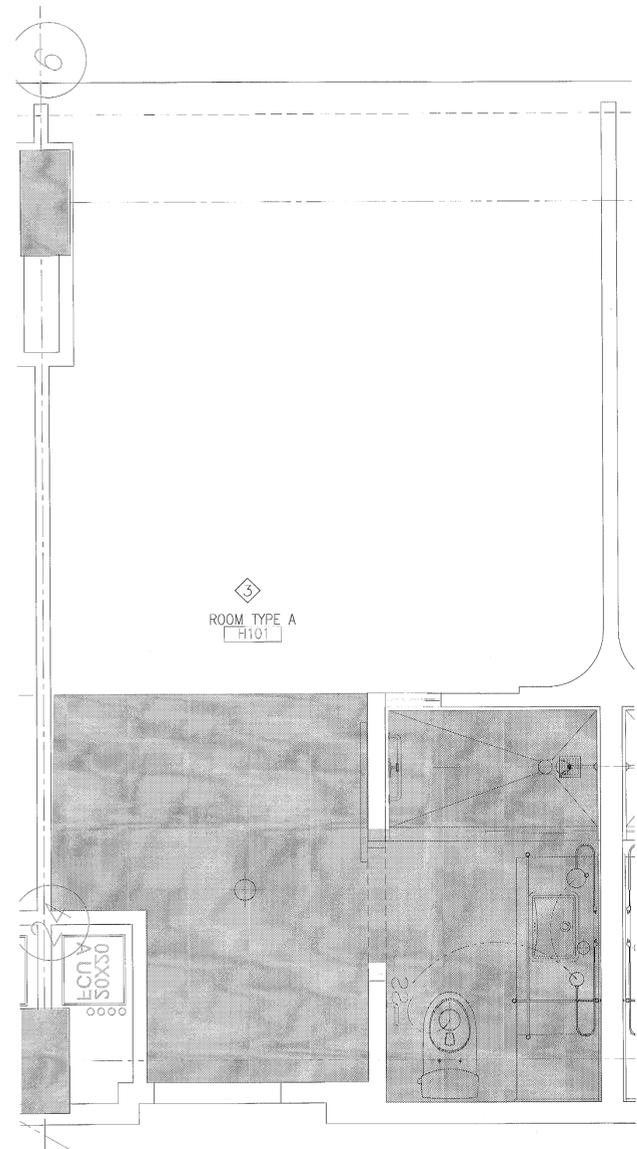


A2 UNIT A REFLECTED CEILING PLAN
SCALE: 1/2" = 1'-0"

FINISH SCHEDULE FOR ALL HOTEL ROOMS

LEVEL	ROOMS	FLOOR		BASE			WALLS								CEILING	REMARKS	
		SIZE	MATERIAL	FINISH	SIZE	MATERIAL	FINISH	NORTH		SOUTH		EAST		WEST			
								MATERIAL	FINISH	MATERIAL	FINISH	MATERIAL	FINISH	MATERIAL			FINISH
H01	ROOM						GYP. BD.	PAINTED	SEE RCP	REFER TO ID DWG'S FOR FINISH NOTES AND INFO							
H02	BATH						GYP. BD.	PAINTED	SEE RCP	REFER TO ID DWG'S FOR FINISH NOTES AND INFO							

- GENERAL HOTEL ROOM NOTES:**
- PROVIDE 3-8" BATT INSULATION ALL SIDES OF PARTITIONS AT: BATHS, A/C CLOSETS AND BETWEEN HOTEL ROOMS.
 - DIMENSIONS TO ALL PLUMBING FIXTURES & APPLIANCES ARE FROM FACE OF GWB TO CENTERLINE OF FIXTURE.
 - SLIDING GLASS DOORS TO PROVIDE A 32" CLEAR OPENING TO BALCONY.
 - SLIDING GLASS DOORS ARE UNABLE TO COMPLY WITH THE FAIR HOUSING ACT THRESHOLD REQUIREMENT DUE TO REQ'D WATER DAM. WHEN NEED ARISES, A RAMP WILL BE PROVIDED.
 - PROVIDE MIN. R-5 INSULATION AT ALL CMU AND CONCRETE SHEARWALLS, EXTERIOR WALLS, AND A/C AREAS ADJACENT TO NON-A/C AREAS, TYP.
 - PROVIDE MIN. R-19 INSULATION AT ROOFS.

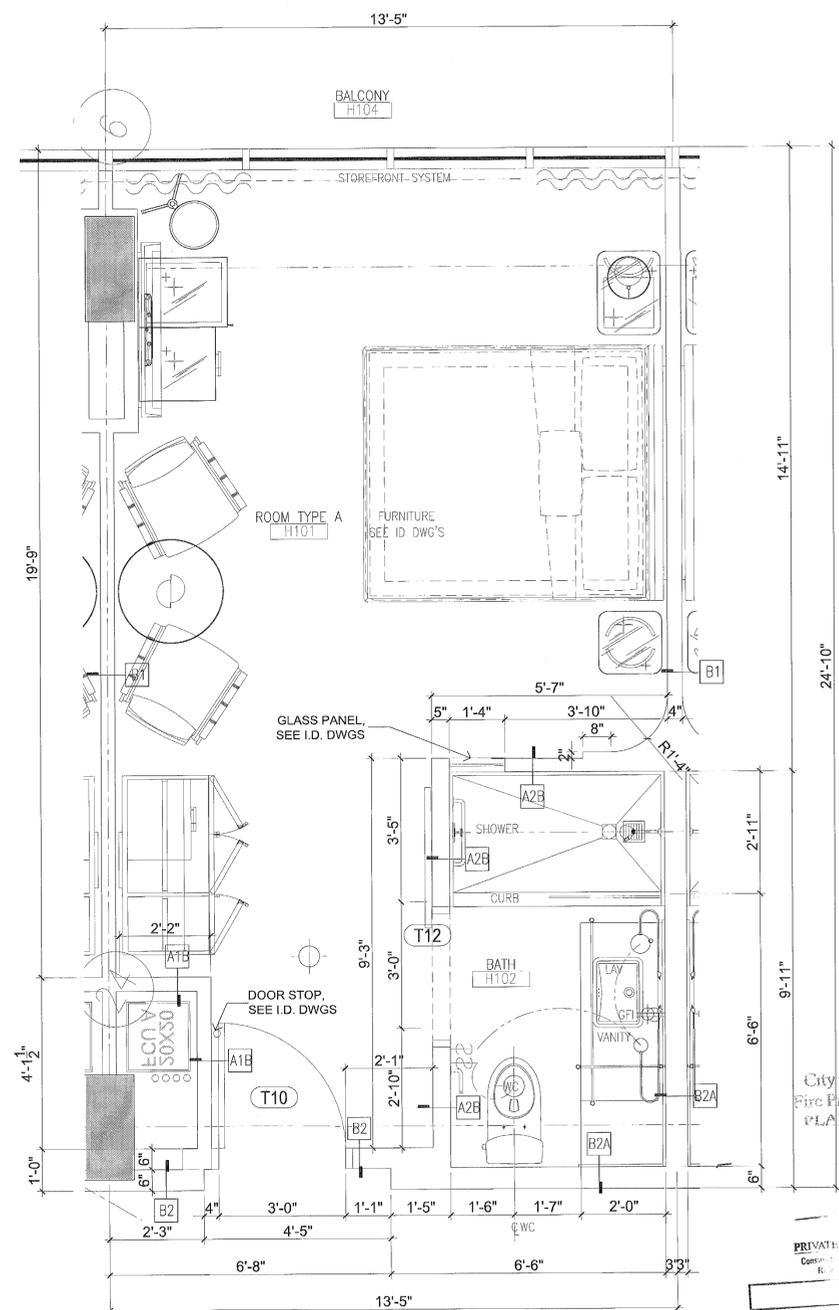

A1 UNIT A PLAN
SCALE: 1/2" = 1'-0"

NO.	DESCRIPTION	DATE
1	PERMIT SET	02.28.17

City of Miami Beach
Fire Prevention Division
PLANS APPROVED

PRIVATE
DATE 02/28/17

BUILDING
STRUCTURAL
MECHANICAL
ELECTRICAL
PLUMBING
SITE CIVIL

PROJECT NO.	1613
DATE	02.28.17
SHEET NO.	
SCALE	As Noted
SHEET NO.	


DOOR #	FROM		TO		SIZE			LABEL	FIRE RATING	MATERIAL	HEAD	JAMB	THRESHOLD	REMARKS
	ROOM NAME	ROOM NAME	TYPE	MATERIAL	PANEL WIDTH	HEIGHT	THICKNESS							
122	DESK	BAGGAGE RM	A	HM	3'-0"	7'-0"	1-3/4"	B	2 HOUR	HM				1
123	MDF CLOSET	BAGGAGE RM	M	WD	5'-4"	7'-0"	1-3/4"			WD				
124	MDF CLOSET	BAGGAGE RM	M	WD	5'-4"	7'-0"	1-3/4"			WD				
125	TOILET	WC CORRIDOR	A	WD	3'-0"	7'-0"	1-3/4"			WD				1

NOTES:

- 1 - EXPOSED CONG. SLAB, PAINT FINISH.
- 2 - SMOOTH 1/2" STUCCO, PAINT FINISH.
- 3 - SMOOTH W/ONCOE, PAINT FINISH.
- 4 - SUSPENDED 1/2" GYP. BD., PAINT FINISH.
- 5 - FIRE SPRINKLER HEADS AND OTHER CEILING FEATURES (ACCESS DOORS, GRILLES, LIGHT FIXTURES, ETC.) ARE SHOWN ONLY FOR ALIGNMENT. FOR THEIR TECHNICAL CHARACTERISTICS (SIZES, QUANTITIES, TYPES, ETC.) REFER TO MECHANICAL AND ELECTRICAL DRAWINGS AND SPECIFICATIONS.
- 6 - GENERAL CONTRACTOR TO SUBMIT SHOP DRAWINGS FOR REVIEW BEFORE INSTALLATION. G.C. TO COORDINATE LOCATIONS AND COORDINATE WITH ALL TRADES PRIOR TO SUBMITTAL.
- 7 - FINISH CEILING HEIGHTS ARE GIVEN FROM TOP OF CONCRETE FLOOR SLAB (UNLESS OTHERWISE NOTED).
- 8 - ALL STOREY AND SANITARY PIPES - VERTICALLY AND HORIZONTALLY - SHALL BE INSULATED (MIN. 1") INCLUDING THE ONES WITHIN DROPPED CEILINGS.
- 9 - ALL PERIMETRAL PARTITIONS AND ALL ABOVE DOOR HEADERS DEFINING A PLENUM AREA, METAL STUDS AND INTERNAL DRYWALL LAYERS MUST EXTEND TO THE UNDERSIDE OF THE CONCRETE SLAB.
- 10 - NO COMBUSTIBLE MATERIALS SHOULD BE ALLOWED IN THE A/C PLENUM AREAS AND A/C CLOSETS. HOWEVER, WHERE APPROVED LIMITED COMBUSTIBLE MATERIALS ARE TO BE USED IN A/C PLENUM AREAS AND A/C CLOSETS, THESE MATERIALS SHALL BE TREATED WITH PLENUM APPROVED PRODUCTS IN ORDER TO ACHIEVE COMPLIANCE WITH THE FLAME SPREAD RATING NOT GREATER THAN 25 AND THE SMOKE DEVELOPED RATING NOT GREATER THAN 50.
- 11 - A/C PLENUM AREAS SHALL BE OF NON COMBUSTIBLE OR LIMITED COMBUSTIBLE MATERIALS, AND HAVE A FLAME SPREAD RATING NOT GREATER THAN 25 AND SMOKE DEVELOPED RATING NOT GREATER THAN 50.

LEGEND

- - CEILING HEIGHTS INDICATED BY THIS SHADE ARE: LEVELS 3-5 - HOTEL 9'-0" A.C.S.
- ◻ - CEILING HEIGHTS INDICATED BY THIS SHADE ARE: LEVELS 3-5 - HOTEL 8'-0" A.C.S. (UNLESS OTHERWISE NOTED) * A.C.S. - ABOVE CONCRETE SLAB
- - OTHER CEILING HEIGHTS A.C.S.
- ▨ - R-19 MIN. INSULATION BOARD AT CEILING
- ◻ - RECESSED WALL MOUNTED LIGHT
- - RECESSED DOWNLIGHT
- - WALL MOUNTED LIGHT
- - JUNCTION BOX
- - WALL MOUNTED "J" BOX
- - A/C SUPPLY (CEILING MOUNTED)
- - A/C SUPPLY (WALL MOUNTED)
- - A/C RETURN (WALL MOUNTED)
- - A/C RETURN GRILLE
- - SOFTLINE
- - HEADER
- - PLENUM AREA
- - 1 HR. RATED WALL
- - 2 HR. RATED WALL

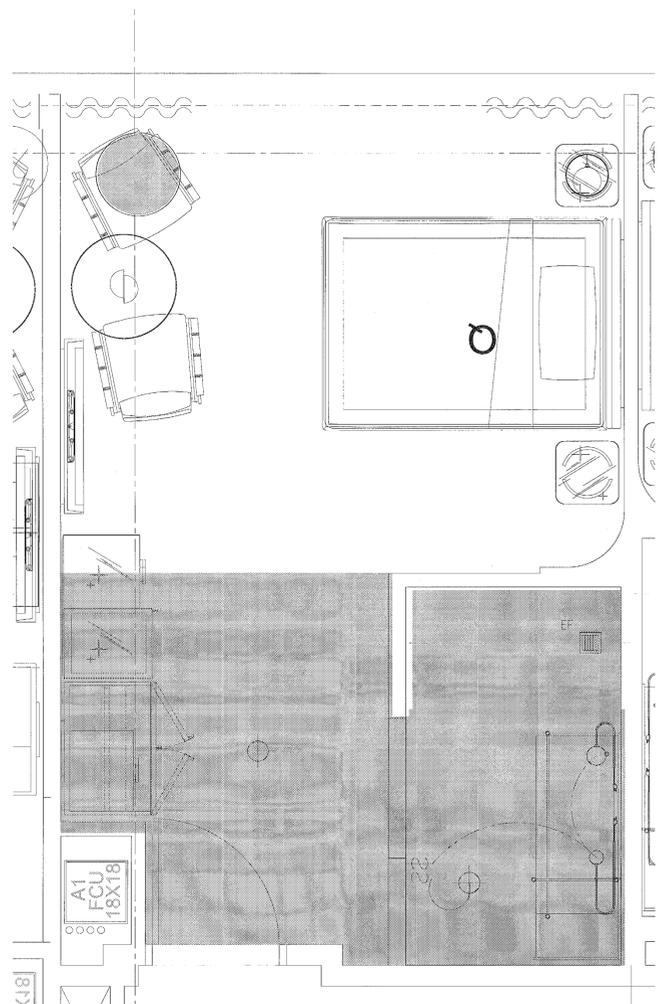


A2 UNIT A1 REFLECTED CEILING PLAN

SCALE: 1/2" = 1'-0"

ROOMS		FLOOR		BASE		WALLS								CEILING	REMARKS	
						NORTH		SOUTH		EAST		WEST				
FLOOR LEVEL	NUM.	NAME	SIZE	MATERIAL	FINISH	SIZE	MATERIAL	FINISH	MATERIAL	FINISH	MATERIAL	FINISH	MATERIAL	FINISH	HEIGHT	FINISH MATERIAL
H02	BATH														SEE RCP	REFER TO ID DWG'S FOR FINISH NOTES AND INFO

GENERAL HOTEL ROOM NOTES:

- PROVIDE 3-8" BATT INSULATION ALL SIDES OF PARTITIONS AT: BATHS, A/C CLOSETS AND BETWEEN HOTEL ROOMS.
- DIMENSIONS TO ALL PLUMBING FIXTURES & APPLIANCES ARE FROM FACE OF GWB TO CENTERLINE OF FIXTURE.
- SLIDING GLASS DOORS TO PROVIDE A 32" CLEAR OPENING TO BALCONY.
- SLIDING GLASS DOORS ARE UNABLE TO COMPLY WITH THE FAIR HOUSING ACT THRESHOLD REQUIREMENT DUE TO REQ'D WATER DAM. WHEN NEED ARISES, A RAMP WILL BE PROVIDED.
- PROVIDE MIN. R-5 INSULATION AT ALL CMU AND CONCRETE SHEARWALLS, EXTERIOR WALLS, AND A/C AREAS ADJACENT TO NON-A/C AREAS, TYP.
- PROVIDE MIN. R-19 INSULATION AT ROOFS.

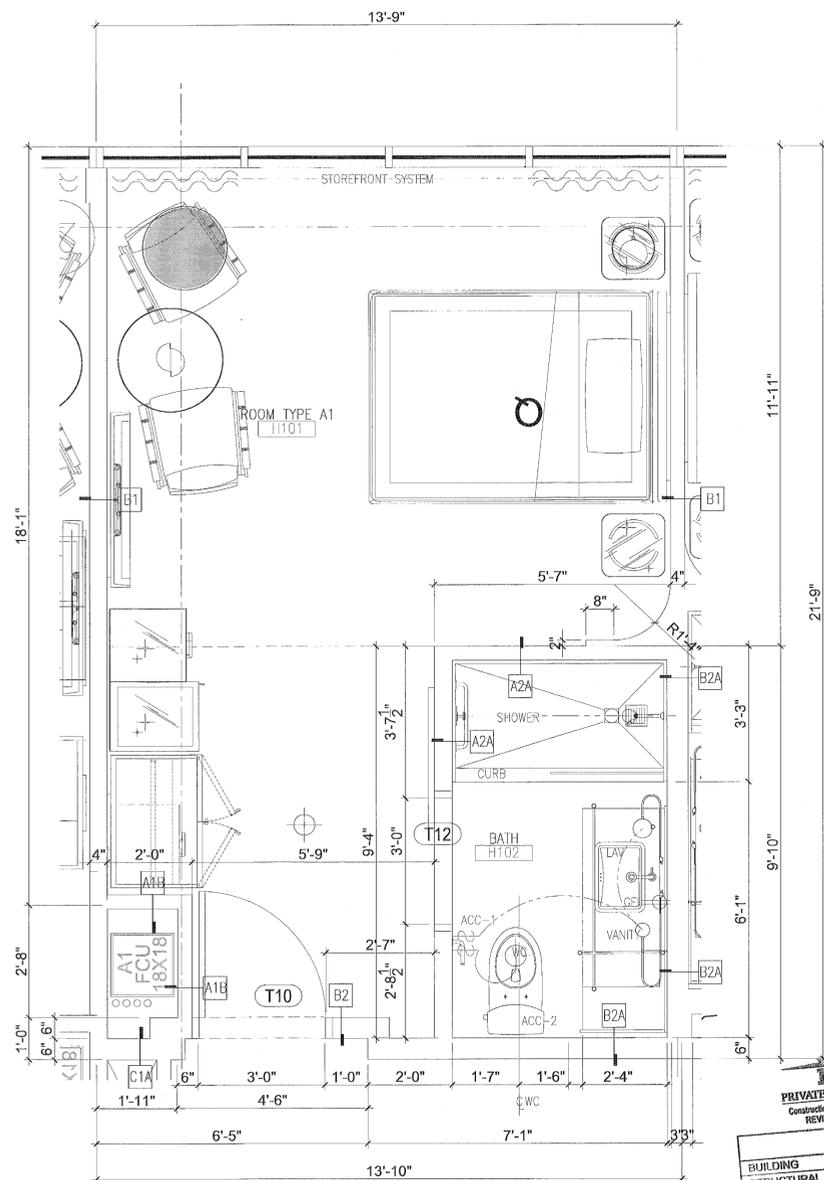

City of Miami Beach
Fire Prevention Division
PLANS APPROVED

PRIVATE PROVIDER SERVICES, LLC
Construction Plans Review, Inspection & Consulting
REVIEWED FOR: [Signature]
DATE: 02/28/17

BUILDING	REVIEWED	DATE
STRUCTURAL		
MECHANICAL		
ELECTRICAL		
PLUMBING		
SITE CIVIL		

A1 UNIT A1 PLAN

SCALE: 1/2" = 1'-0"

PERMUY
ARCHITECTURE
INTERIOR DESIGN
PLANNING
2717 Ponce de Leon Blvd.
Coral Gables, FL, 33134
Phone : 305.200.5302
www.PermuyArchitecture.com

STATE OF FLORIDA
REGISTERED ARCHITECT
REGISTRATION #02024951
THESE DESIGNS AND DRAWINGS ARE THE COPYRIGHTED PROPERTY OF PERMUY ARCHITECTURE INTERIOR DESIGN AND PLANNING, INC. AND MAY NOT BE REPRODUCED OR COPIED WITHOUT WRITTEN CONSENT OF THE ARCHITECT. THE CONTRACTOR MUST CHECK AND VERIFY ALL DIMENSIONS OF THE JOB AND BE RESPONSIBLE FOR SAME. REPORTING ANY DISCREPANCIES TO THE ARCHITECT BEFORE COMMENCING WORK. DRAWINGS ARE NOT TO BE SCALED.

KIMPTON HOTEL
PALOMAR
SOUTH BEACH
1750 Alton Road, Miami Beach, FL 33139
FINVARB GROUP
1065 Karne Concourse, Suite 201, Bay Harbor Island, FL 33154

No.	DESCRIPTION	DATE
	PERMIT SET	02.28.17

PROJECT NO: 1613
DATE: 02.28.17
SHEET INDEX:
SCALE: As Noted
SHEET NO.

